

WATER WELL PLUGGING RECORD Form WWC-5P

KSA 82a-1212 ID NO.

1 LOCATION OF WATER WELL:

County: Saline

Fraction

NW 1/4 NW 1/4 NE 1/4

Section Number

12

Township Number

T 13 S

Range Number

3☐ E ☒ WStreet/Rural Address of Well Location; if unknown, distance & direction from nearest town or intersection: If at owner's address, check here ☐ 730 ft NW of 691 DocHoliday Pass Salina KS 67401

Global Positioning Systems (GPS) information:

Latitude: 38.9416396 (in decimal degrees)Longitude: -97.6026101 (in decimal degrees)Elevation: 1242

Datum:

☐ WGS84,☐ NAD83,☐ NAD27

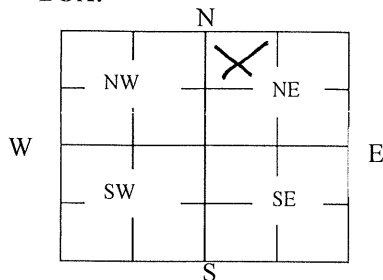
Collection Method:

☐ GPS unit (Make/Model):☒ Digital Map/Photo, ☒ Topographic Map, ☐ Land SurveyEst. Accuracy: ☐ < 3 m, ☐ 3-5 m, ☒ 5-15 m, ☐ > 15 m

2 WATER WELL OWNER:

Ottawa Co. RWD #2RR#, St. Address, Box #: PO Box 3551City, State ZIP Code: Salina, KS 67402

3 MARK WELL'S LOCATION WITH AN "X" IN SECTION BOX:

4 DEPTH OF WELL 110 ft.WELL'S STATIC WATER LEVEL 48 ft.

WELL WAS USED AS:

☐ Domestic
☐ Irrigation
☐ Feedlot
☐ Industrial

☐ Public Water Supply
☐ Oil Field Water Supply
☐ Domestic (Lawn & Garden)
☐ Air Conditioning

☒ Dewatering
☐ Monitoring
☐ Injection Well
☐ Other
Was a chemical/bacteriological sample submitted to Department? Yes ☐ No ☒

5 TYPE OF BLANK CASING USED:

☐ Steel
☒ PVC☐ RMP (SR)
☐ ABS☐ Wrought
☐ Asbestos-Cement☐ Fiberglass
☐ Concrete Tile☐ Other (Specify below)Blank casing diameter 2.5 in. Was casing pulled? Yes ☐ No ☒ If yes, how much _____
Casing height above or below land surface 36 in.

6 GROUT PLUG MATERIAL:

☐ Neat cement☐ Cement grout☒ Bentonite☒ Other SoilGrout Plug Intervals: From 112 ft. to 3 ft., From 3 ft. to 0 ft., From _____ ft. to _____ ft.

What is the nearest source of possible contamination:

☐ Septic tank
☐ Sewer lines
☐ Watertight sewer lines
☐ Lateral lines
☐ Cess pool

☐ Seepage pit
☐ Pit privy
☐ Sewage lagoon
☐ Feedyard
☐ Livestock pens

☐ Fuel storage
☐ Fertilizer storage
☐ Insecticide storage
☒ Abandoned water well
☐ Oil well/Gas well
☐ Other (specify below)Direction from well? North
How many feet? 400

FROM	TO	PLUGGING MATERIALS	FROM	TO	PLUGGING MATERIALS
<u>112</u>	<u>3</u>	<u>Bentonite Clay</u>	<u>3</u>	<u>0</u>	<u>Soil</u>

7 CONTRACTOR'S OR LANDOWNER'S CERTIFICATION:

This water well was plugged under my jurisdiction and was completed on (mo/day/year) 8/29/23 and this record is true to the best of my knowledge and belief. Kansas Water Well Contractor's License No. N/A. This Water Well Record was completed on (mo/day/year) 8/29/23 under the business name of Ottawa Co. RWD #2 by (signature) Josh Werner

Send one white copy to Kansas Department of Health & Environment, Geology Section, 1000 SW Jackson Street, Ste. 420, Topeka, KS 66612-1367. Send one copy to WATER WELL OWNER and retain one for your records.

Visit us at <http://www.kdheks.gov/waterwell/index.html> Telephone 785-296-5524.

KSA82a-1212

Revised 1/20/2015