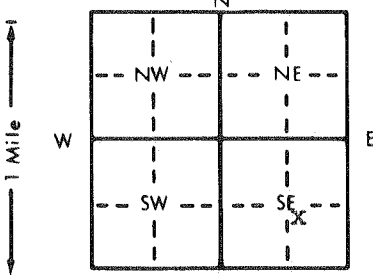


1 LOCATION OF WATER WELL: Fraction NW 1/4 SE 1/4 SE 1/4 Section Number 2 Township Number T 13 S Range Number R 3 EW
 County: SALINE
 Distance and direction from nearest town or city street address of well if located within city?
 313 W. ROBSON RD.

2 WATER WELL OWNER: L.M. GAMBELL
 RR#, St. Address, Box #: 313 W. ROBSON RD.
 City, State, ZIP Code: SALINA, KS. 67401
 Board of Agriculture, Division of Water Resources
 Application Number:

3 LOCATE WELL'S LOCATION WITH AN "X" IN SECTION BOX:

 4 DEPTH OF COMPLETED WELL: ~~84~~ 120 ft. ELEVATION:
 Depth(s) Groundwater Encountered 1. 46 ft. 2. ft. 3. ft.
 WELL'S STATIC WATER LEVEL 46 ft. below land surface measured on mo/day/yr 8-21-93
 Pump test data: Well water was 52 ft. after 8 hours pumping 15 gpm
 Est. Yield 75 gpm: Well water was ft. after hours pumping gpm
 Bore Hole Diameter 9 in. to ~~8 1/2~~ 120 ft., and in. to ft.
 WELL WATER TO BE USED AS:
 1 Domestic 3 Feedlot 6 Oil field water supply 9 Dewatering 12 Other (Specify below)
 2 Irrigation 4 Industrial 7 Lawn and garden only 10 Monitoring well
 Was a chemical/bacteriological sample submitted to Department? Yes.....No. ; If yes, mo/day/yr sample was submitted
 Water Well Disinfected? Yes No

5 TYPE OF BLANK CASING USED:
 1 Steel 3 RMP (SR) 5 Wrought iron 8 Concrete tile CASING JOINTS: Glued Clamped
 2 PVC 4 ABS 6 Asbestos-Cement 9 Other (specify below) Welded
 7 Fiberglass Threaded
 Blank casing diameter 5 in. to ~~8 1/2~~ 117 ft., Dia. in. to ft., Dia. in. to ft.
 Casing height above land surface 14 in., weight 160 lbs./ft. Wall thickness or gauge No. SDR 26
 TYPE OF SCREEN OR PERFORATION MATERIAL:
 1 Steel 3 Stainless steel 5 Fiberglass 8 RMP (SR) 10 Asbestos-cement
 2 Brass 4 Galvanized steel 6 Concrete tile 9 ABS 12 None used (open hole)
 SCREEN OR PERFORATION OPENINGS ARE:
 1 Continuous slot 3 Mill slot .035 6 Wire wrapped 9 Drilled holes
 2 Louvered shutter 4 Key punched ~~8 1/2~~ 117 7 Torch cut ~~8 1/2~~ 120 10 Other (specify)
 SCREEN-PERFORATED INTERVALS: From ft. to ft., From ft. to ft.
 GRAVEL PACK INTERVALS: From 49 ft. to ~~8 1/2~~ 120 ft., From ft. to ft.

6 GROUT MATERIAL: 1 Neat cement 2 Cement grout 3 Bentonite 4 Other
 Grout Intervals: From 5 ft. to 25 ft., From ~~46~~ 100 ft. to ~~49~~ 103 ft., From ft. to ft.
 What is the nearest source of possible contamination:
 1 Septic tank 4 Lateral lines 7 Pit privy 10 Livestock pens 14 Abandoned water well
 2 Sewer lines 5 Cess pool 8 Sewage lagoon 11 Fuel storage 15 Oil well/Gas well
 3 Watertight sewer lines 6 Seepage pit 9 Feedyard 12 Fertilizer storage 16 Other (specify below)
 13 Insecticide storage
 Direction from well? SOUTH How many feet? 100

FROM	TO	LITHOLOGIC LOG	FROM	TO	PLUGGING INTERVALS
0	1	TOP SOIL			
1	3	CLAY RED			
3	22	SANDSTONE TAN			
22	45	CLAY GRAY			
45	120	SANDSTONE TAN FINE GRAIN			

7 CONTRACTOR'S OR LANDOWNER'S CERTIFICATION: This water well was (1) constructed, (2) reconstructed, or (3) plugged under my jurisdiction and was completed on (mo/day/year) 8-21-93 and this record is true to the best of my knowledge and belief. Kansas Water Well Contractor's License No. 388 This Water Well Record was completed on (mo/day/yr) 8-21-93 under the business name of PESTINGER PUMP SERVICE by (signature) Paul Pestinger