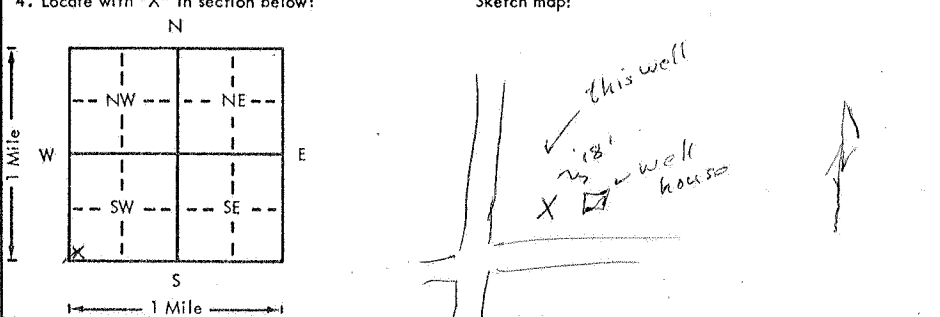


USE TYPEWRITER OR BALL POINT PEN-PRESS FIRMLY, PRINT CLEARLY.

WATER WELL RECORD  
KSA 82a-1201-1215

Kansas Department of Health and Environment-Division of Environment (Water well Contractors) Topeka, Kansas 66620

1. Location of well:		County <i>Saline</i>	Fraction <i>SW 1/4 SW 1/4 SW 1/4</i>	Section number <i>13</i>	Township number <i>T 13 S R 3</i>	Range number <i>EW</i>
2. Distance and direction from nearest town or city: Street address of well location if in city: <i>2 N. Salina</i>				3. Owner of well: <i>Charles Howison</i> R.R. or street: <i>Rt. 2</i> City, state, zip code: <i>Salina Kans 67401</i>		
4. Locate with "X" in section below: 				6. Bore hole dia. <i>8"</i> in. Completion date <i>2-10-76</i> Well depth <i>58</i> ft.		
5. Type and color of material				7. <input checked="" type="checkbox"/> Cable tool <input checked="" type="checkbox"/> Rotary <input type="checkbox"/> Driven <input type="checkbox"/> Dug <input type="checkbox"/> Hollow rod <input type="checkbox"/> Jetted <input type="checkbox"/> Bored <input type="checkbox"/> Reverse rotary		
				8. Use: <input checked="" type="checkbox"/> Domestic <input checked="" type="checkbox"/> Public supply <input type="checkbox"/> Industry <input type="checkbox"/> Irrigation <input type="checkbox"/> Air conditioning <input type="checkbox"/> Stock <input type="checkbox"/> Lawn <input type="checkbox"/> Oil field water <input type="checkbox"/> Other		
				9. Casing: Material <i>PVC</i> Height: <i>Above</i> or below Threaded <input type="checkbox"/> Welded <input type="checkbox"/> Surface <i>30</i> in. RMP <input type="checkbox"/> PVC <input type="checkbox"/> Weight <input type="checkbox"/> lbs./ft. Dia. <i>5</i> in. to <i>58</i> ft. depth   Wall Thickness: inches or Dia. <input type="checkbox"/> in. to <input type="checkbox"/> ft. depth   gage No. <i>Q. 858</i>		
				10. Screen: Manufacturer's name <i>Shop</i> Type <i>PVC slots</i> Dia. <i>5"</i> Slot/gauze <i>3/32</i> Length <i>10</i> Set between <i>47</i> ft. and <i>54</i> ft. <i>55-58</i> ft. and <input type="checkbox"/> ft. Gravel pack? <input checked="" type="checkbox"/> Size range of material <i>3/8</i>		
				11. Static water level: <input type="checkbox"/> mo./day/yr. <i>27</i> ft. below land surface Date <i>2-10-76</i>		
				12. Pumping level below land surfaces: <input type="checkbox"/> ft. after <input type="checkbox"/> hrs. pumping <input type="checkbox"/> g.p.m. <input type="checkbox"/> ft. after <input type="checkbox"/> hrs. pumping <input type="checkbox"/> g.p.m. Estimated maximum yield <input type="checkbox"/> g.p.m.		
				13. Water sample submitted: <input type="checkbox"/> mo./day/yr. <input type="checkbox"/> Yes <input checked="" type="checkbox"/> No Date <input type="checkbox"/>		
				14. Well head completion: <input checked="" type="checkbox"/> Pitless adapter <input type="checkbox"/> Inches above grade		
				15. Well grouted? <input checked="" type="checkbox"/> With: <input checked="" type="checkbox"/> Neat cement <input type="checkbox"/> Bentonite <input type="checkbox"/> Concrete Depth: From <i>3</i> ft. to <i>23</i> ft.		
				16. Nearest source of possible contamination: ft. <i>60</i> Direction <i>west</i> Type <i>ditch</i> Well disinfected upon completion? <input checked="" type="checkbox"/> Yes <input type="checkbox"/> No		
				17. Pump: <input type="checkbox"/> Not installed Manufacturer's name <i>Myers</i> Model number <input type="checkbox"/> HP <i>5</i> Volts <i>230</i> Length of drop pipe <i>50</i> ft. capacity <i>30</i> g.p.m. Type: <input checked="" type="checkbox"/> Submersible <input type="checkbox"/> Turbine <input type="checkbox"/> Jet <input type="checkbox"/> Reciprocating <input type="checkbox"/> Centrifugal <input type="checkbox"/> Other		
				20. Water well contractor's certification: This well was drilled under my jurisdiction and this report is true to the best of my knowledge and belief. <i>Myers Drilling Co. 126</i> License No. Address <i>Salina Kansas</i> Signed <i>Paul Faust</i> Date <i>5-17-76</i> Authorized representative		
18. Elevation:		19. Remarks:				
Topography: <input type="checkbox"/> Hill <input type="checkbox"/> Slope <input type="checkbox"/> Upland <input checked="" type="checkbox"/> Valley		<i>Water level probably low for pumping well 18' E</i>				

Forward the white; blue and pink copies to the Department of Health and Environment

Form WWC-5

