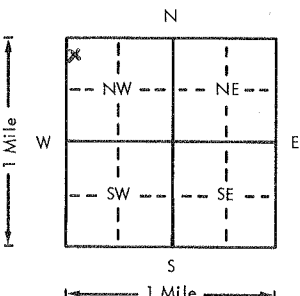


USE TYPEWRITER OR BALL POINT PEN—PRESS FIRMLY, PRINT CLEARLY.

WATER WELL RECORD
KSA 82a-1201-1215

Kansas Department of Health and Environment—Division of Environment
(Water well Contractors)
Topeka, Kansas 66620

1. Location of well:		County Saline	Fraction Lot 13 NW 1/4 NW 1/4 NW 1/4	Section number 19	Township number T 13	Range number S R 3 W	E/W E/W
2. Distance and direction from nearest town or city: 2 Mi N + 4 W Street address of well location if in city: Salina Ks				3. Owner of well: Gus Reed R.R. or street: 421 N. Ohio City, state, zip code: Salina Ks. 67401			
4. Locate with "X" in section below: 				Sketch map: test hole #8		6. Bore hole dia. 6 in. Completion date _____ Well depth 130 ft. 9-15-77	
5. Type and color of material				From	To	7. <input checked="" type="checkbox"/> Cable tool <input checked="" type="checkbox"/> Rotary <input type="checkbox"/> Driven <input type="checkbox"/> Dug <input type="checkbox"/> Hollow rod <input type="checkbox"/> Jetted <input type="checkbox"/> Bored <input type="checkbox"/> Reverse rotary	
Colluvium: Rubble & silt, brown				0	2	8. Use: <input checked="" type="checkbox"/> Domestic <input type="checkbox"/> Public supply <input type="checkbox"/> Industry <input type="checkbox"/> Irrigation <input type="checkbox"/> Air conditioning <input type="checkbox"/> Stock <input type="checkbox"/> Lawn <input type="checkbox"/> Oil field water <input type="checkbox"/> Other	
Dakota +/or Kiowa fm:						9. Casing: Material _____ Height: Above or below Threaded _____ Welded _____ Surface 12 in. RMP _____ PVC <input checked="" type="checkbox"/> Weight _____ lbs./ft. Dia. 4 in. to 130 ft. depth Wall Thickness: inches or Dia. _____ in. to _____ ft. depth gage No. 5. 40	
Shale, yellow + gray, contains some sandstone				2	71	10. Screen: Manufacturer's name Shop Type slots Dia. 4" Slot/gauze 3/32" Length 50' Set between 60 ft. and 90 ft. 110 ft. and 130 ft. Gravel pack? <input checked="" type="checkbox"/> Size range of material 3/8"	
Siltstone, sandy, light gray				71	86	11. Static water level: _____ mo./day/yr. 48 ft. below land surface Date 8-1-77	
Shale, gray				86	123	12. Pumping level below land surfaces: ND ft. after 1 hrs. pumping 10 g.p.m. _____ ft. after _____ hrs. pumping _____ g.p.m. Estimated maximum yield 10 g.p.m.	
Sandstone, fine, silty, gray				123	127	13. Water sample submitted: _____ mo./day/yr. <input type="checkbox"/> Yes <input checked="" type="checkbox"/> No Date _____	
Shale + siltstone, gray				127	152	14. Well head completion: <input type="checkbox"/> Pitless adapter 12 Inches above grade	
Mississal shale:						15. Well grouted? <input checked="" type="checkbox"/> With: <input checked="" type="checkbox"/> Neat cement <input type="checkbox"/> Bentonite <input type="checkbox"/> Concrete Depth: From 3 ft. to 13 ft.	
Shale, red + green				152	155	16. Nearest source of possible contamination: Open field ft. _____ Direction _____ Type _____ Well disinfected upon completion? <input checked="" type="checkbox"/> Yes <input type="checkbox"/> No	
(Use a second sheet if needed)						17. Pump: <input checked="" type="checkbox"/> Not installed Manufacturer's name _____ Model number _____ HP _____ Volts _____ Length of drop pipe _____ ft. capacity _____ g.p.m. Type: <input type="checkbox"/> Submersible <input type="checkbox"/> Turbine <input type="checkbox"/> Jet <input type="checkbox"/> Reciprocating <input type="checkbox"/> Centrifugal <input type="checkbox"/> Other	
18. Elevation:		19. Remarks:		20. Water well contractor's certification: This well was drilled under my jurisdiction and this report is true to the best of my knowledge and belief. Hydraulic Drilling 126 Business name _____ License No. _____ Address Salina Kansas Signed Orl Faust 9-29-77 Date Authorized representative			

T 13
 R 3 W
 Sec 19
 NW 1/4 NW 1/4 NW 1/4

Forward the white, blue and pink copies to the Department of Health and Environment

Form WWC-5