


LOCATION OF WATER WELL: County: <u>Saline</u>	Fraction <u>NE</u> 1/4 <u>NE</u> 1/4 <u>NW</u> 1/4	Section Number <u>20</u>	Township Number T <u>13</u> S	Range Number R <u>3</u> EW
--	---	-----------------------------	----------------------------------	-------------------------------

Distance and direction from nearest town or city street address of well if located within city?  
# 3 miles north 3 1/2 west of Salina on 81 Highway

WATER WELL OWNER: Saline County RWD #4  
RR#, St. Address, Box # : P.O. 1044  
City, State, ZIP Code : Salina, Ks. 67402-1044  
Board of Agriculture, Division of Water Resources  
Application Number:

LOCATE WELL'S LOCATION WITH AN "X" IN SECTION BOX: 4 DEPTH OF COMPLETED WELL... 76 ft. ELEVATION: 1100 ft.

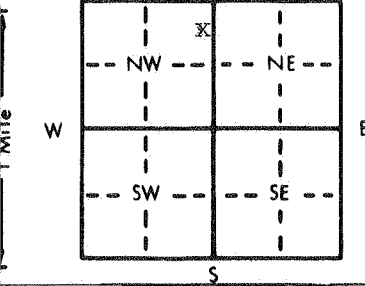

Depth(s) Groundwater Encountered 1. 18 ft. 2. 18 ft. 3. 18 ft.  
WELL'S STATIC WATER LEVEL 18 ft. below land surface measured on mo/day/yr  
Pump test data: Well water was NA ft. after NA hours pumping NA gpm  
Est. Yield NA gpm: Well water was NA ft. after NA hours pumping NA gpm  
Bore Hole Diameter 3 in. to 3 ft., and 3 in. to 3 ft.  
WELL WATER TO BE USED AS:  
5 Public water supply 8 Air conditioning 11 Injection well  
1 Domestic 3 Feedlot 6 Oil field water supply 9 Dewatering 12 Other (Specify below)  
2 Irrigation 4 Industrial 7 Lawn and garden only 10 Observation well  
Was a chemical/bacteriological sample submitted to Department? Yes NA No X; If yes, mo/day/yr sample was submitted  
Water Well Disinfected? Yes X No

TYPE OF BLANK CASING USED:  
1 Steel 3 RMP (SR) 5 Wrought iron 8 Concrete tile CASING JOINTS: Glued NA Clamped NA  
2 PVC 4 ABS 6 Asbestos-Cement 9 Other (specify below) Welded NA  
7 Fiberglass Threaded NA  
Blank casing diameter NA in. to NA ft., Dia NA in. to NA ft., Dia NA in. to NA ft.  
Casing height above land surface NA in., weight NA lbs./ft. Wall thickness or gauge No. NA

TYPE OF SCREEN OR PERFORATION MATERIAL:  
1 Steel 3 Stainless steel 5 Fiberglass 7 PVC 10 Asbestos-cement  
2 Brass 4 Galvanized steel 6 Concrete tile 8 RMP (SR) 11 Other (specify) NA  
12 None used (open hole)

SCREEN OR PERFORATION OPENINGS ARE:  
1 Continuous slot 3 Mill slot 5 Gauzed wrapped 8 Saw cut 11 None (open hole)  
2 Louvered shutter 4 Key punched 6 Wire wrapped 9 Drilled holes  
7 Torch cut 10 Other (specify) NA

SCREEN-PERFORATED INTERVALS: From NA ft. to NA ft., From NA ft. to NA ft.  
From NA ft. to NA ft., From NA ft. to NA ft.  
GRAVEL PACK INTERVALS: From NA ft. to NA ft., From NA ft. to NA ft.  
From NA ft. to NA ft., From NA ft. to NA ft.

GROUT MATERIAL: X Neat cement 2 Cement grout 3 Bentonite 4 Other Well Plug  
Grout Intervals: From 2 ft. to 25 ft., From 25 ft. to 30 ft., From 30 ft. to NA ft.

What is the nearest source of possible contamination:  
1 Septic tank 4 Lateral lines 7 Pit privy 11 Fuel storage 14 Abandoned water well  
2 Sewer lines 5 Cess pool 8 Sewage lagoon 12 Fertilizer storage 15 Oil well/Gas well  
3 Watertight sewer lines 6 Seepage pit 9 Feedyard 13 Insecticide storage 16 Other (specify below)

Direction from well? West How many feet? 3

FROM	TO	LITHOLOGIC LOG	FROM	TO	LITHOLOGIC LOG
1	2	Top Soil			
2	25	Neat Cement			
25	30	Bentonite Well Plug			
30	76	Chlorinated Sand & Gravel			
		76' of 2 1/2 Well Casing was pulled from well			

CONTRACTOR'S OR LANDOWNER'S CERTIFICATION: This water well was (1) constructed, (2) reconstructed, or (3) plugged under my jurisdiction and was completed on (mo/day/year) 5-29-87 and this record is true to the best of my knowledge and belief. Kansas Water Well Contractor's License No. 388 This Water Well Record was completed on (mo/day/year) 5-29-87 under the business name of Pestinger Pump Service by (signature) Paul J. Pestinger

INSTRUCTIONS: Use typewriter or ball point pen. PLEASE PRESS FIRMLY and PRINT clearly. Please fill in blanks, underline or circle the correct answers. Send top three copies to Kansas Department of Health and Environment, Office of Oil Field and Environmental Geology, Regulation and Permitting Section, Topeka, Kansas 66620-7500, Telephone: 913-862-9360. Send one to WATER WELL OWNER and retain one for your records.