


1 LOCATION OF WATER WELL: County: Hogan Fraction: NE 1/4 NW 1/4 SE 1/4 Section Number: 19 Township Number: T 13 S Range Number: R 33 E 10

Distance and direction from nearest town or city street address of well if located within city?
13 1/2 1/2 west Monument

2 WATER WELL OWNER: Fern Wiland
 RR#, St. Address, Box #: Oakley, Kansas
 City, State, ZIP Code: Oakley, Kansas
 Board of Agriculture, Division of Water Resources
 Application Number:

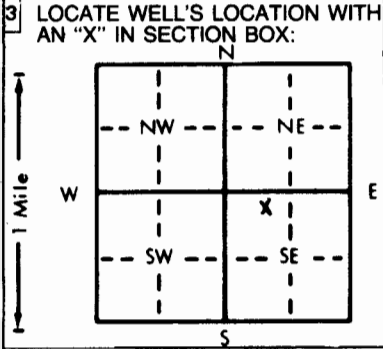

4 DEPTH OF COMPLETED WELL: 21 ft. ELEVATION: 8-18-81
 Depth(s) Groundwater Encountered 1. 11 ft. 2. 11 ft. 3. 11 ft.
 WELL'S STATIC WATER LEVEL 11 ft. below land surface measured on mo/day/yr 8-18-81
 Pump test data: Well water was 5 gpm: Well water was 9 in. to 21 ft. after 5 hours pumping 5 gpm
 Est. Yield 5 gpm: Well water was 9 in. to 21 ft. after 5 hours pumping 5 gpm
 Bore Hole Diameter 9 in. to 21 ft. and 9 in. to 21 ft.
 WELL WATER TO BE USED AS:
 5 Public water supply 8 Air conditioning 11 Injection well
 1 Domestic 3 Feedlot 6 Oil field water supply 9 Dewatering 12 Other (Specify below) Stock
 2 Irrigation 4 Industrial 7 Lawn and garden only 10 Observation well
 Was a chemical/bacteriological sample submitted to Department? Yes X No X; If yes, mo/day/yr sample was submitted
 Water Well Disinfected? Yes X No

5 TYPE OF BLANK CASING USED:
 1 Steel 3 RMP (SR) 5 Wrought iron 8 Concrete tile CASING JOINTS: Glued ✓ Clamped
 2 PVC 4 ABS 6 Asbestos-Cement 9 Other (specify below) Welded
 7 Fiberglass Threaded
 Blank casing diameter 0 in. to 10 ft., Dia 0 in. to 10 ft., Dia 0 in. to 10 ft.
 Casing height above land surface 12 in., weight 214 lbs./ft. Wall thickness or gauge No. 214
 TYPE OF SCREEN OR PERFORATION MATERIAL:
 1 Steel 3 Stainless steel 5 Fiberglass 8 RMP (SR) 10 Asbestos-cement
 2 Brass 4 Galvanized steel 6 Concrete tile 9 ABS 11 Other (specify)
 12 None used (open hole)
 SCREEN OR PERFORATION OPENINGS ARE:
 1 Continuous slot 3 Mill slot 5 Gauzed wrapped 8 Saw cut 11 None (open hole)
 2 Louvered shutter 4 Key punched 6 Wire wrapped 9 Drilled holes
 7 Torch cut 10 Other (specify)
 SCREEN-PERFORATED INTERVALS: From 10 ft. to 21 ft., From 10 ft. to 21 ft., From 10 ft. to 21 ft.
 GRAVEL PACK INTERVALS: From 10 ft. to 21 ft., From 10 ft. to 21 ft., From 10 ft. to 21 ft.

6 GROUT MATERIAL: 1 Neat cement 2 Cement grout 3 Bentonite 4 Other
 Grout Intervals: From 0 ft. to 10 ft., From 10 ft. to 21 ft., From 10 ft. to 21 ft.
 What is the nearest source of possible contamination:
 1 Septic tank 2 Lateral lines 7 Pit privy 10 Livestock pens 14 Abandoned water well
 2 Sewer lines 5 Cess pool 8 Sewage lagoon 11 Fuel storage 15 Oil well/Gas well
 3 Watertight sewer lines 6 Seepage pit 9 Feedyard 12 Fertilizer storage 16 Other (specify below) Draw
 13 Insecticide storage
 Direction from well? 300 How many feet?

FROM	TO	LITHOLOGIC LOG	FROM	TO	LITHOLOGIC LOG
0	4	Top soil	0	4	Top soil
4	9	Sandy clay	4	9	Sandy clay
9	13	M. gravel	9	13	M. gravel
13	21	Clay	13	21	Clay

7 CONTRACTOR'S OR LANDOWNER'S CERTIFICATION: This water well was 1 constructed, (2) reconstructed, or (3) plugged under my jurisdiction and was completed on (mo/day/year) 8-27 and this record is true to the best of my knowledge and belief. Kansas Water Well Contractor's License No. 376 This Water Well Record was completed on (mo/day/yr) 9-4-81 under the business name of B+B Dullens by (signature) Joseph Beckman

INSTRUCTIONS: Use typewriter or ball point pen, PLEASE PRESS FIRMLY and PRINT clearly. Please fill in blanks, underline or circle the correct answers. Send top three copies to Kansas Department of Health and Environment, Division of Environment, Environmental Geology Section, Topeka, KS 66620. Send one to WATER WELL OWNER and retain one for your records.

OFFICE USE ONLY
T
R
33
E
10
19
NW
1/4
SE
1/4