


1 LOCATION OF WATER WELL: County: WALLACE Fraction SE 1/4 NE 1/4 SW 1/4 Section Number 23 Township Number T 13 S Range Number R 38 E/W

Distance and direction from nearest town or city street address of well if located within city?

2 WATER WELL OWNER: JERRY W WRIGHT RR#, St. Address, Box #: 3190 VESPER ROAD City, State, ZIP Code: WALLACE, KS. 67761 Board of Agriculture, Division of Water Resources Application Number: 9101

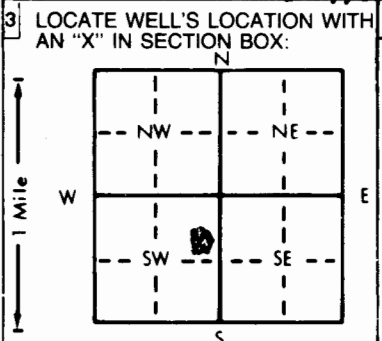

3 LOCATE WELL'S LOCATION WITH AN "X" IN SECTION BOX: 4 DEPTH OF COMPLETED WELL: 36 ft. ELEVATION: ... Depth(s) Groundwater Encountered: 1. 12 ft. 2. ... WELL'S STATIC WATER LEVEL: 12 ft. below land surface measured on mo/day/yr 7-24-07 Pump test data: Well water was 27 ft. after 3 hours pumping 250 gpm Est. Yield 250 gpm: Well water was ... Bore Hole Diameter: 30 in. to 34.5 ft., and 17 in. to 36 ft. WELL WATER TO BE USED AS: 1 Domestic (checked) 2 Irrigation (checked) 3 Feedlot 4 Industrial 5 Public water supply 6 Oil field water supply 7 Lawn and garden only 8 Air conditioning 9 Dewatering 10 Monitoring well 11 Injection well 12 Other (Specify below) Was a chemical/bacteriological sample submitted to Department? Yes (No) If yes, mo/day/yr sample was submitted Water Well Disinfected? Yes (checked) HTH No

5 TYPE OF BLANK CASING USED: 1 Steel (checked) 2 PVC 3 RMP (SR) 4 ABS 5 Wrought iron 6 Asbestos-Cement 7 Fiberglass 8 Concrete tile 9 Other (specify below) 10 Asbestos-cement CASING JOINTS: Glued Clamped Welded (checked) Threaded

Blank casing diameter: 16 in. to 15 ft., Dia. 16 in. to 24'-37' Dia. Casing height above land surface: 12 in., weight 42.05 lbs./ft. Wall thickness or gauge No. 250

TYPE OF SCREEN OR PERFORATION MATERIAL: 1 Steel 2 Brass 3 Stainless steel (checked) 4 Galvanized steel 5 Fiberglass 6 Concrete tile 7 PVC 8 RMP (SR) 9 ABS 10 Asbestos-cement 11 Other (specify) 12 None used (open hole)

SCREEN OR PERFORATION OPENINGS ARE: 1 Continuous slot (checked) 2 Louvered shutter 3 Mill slot 4 Key punched 5 Gauzed wrapped 6 Wire wrapped (checked) 7 Torch cut 8 Saw cut 9 Drilled holes 10 Other (specify) 11 None (open hole)

SCREEN-PERFORATED INTERVALS: From 15 ft. to 27 ft., From ... GRAVEL PACK INTERVALS: From 12 ft. to 37 ft., From ...

6 GROUT MATERIAL: 1 Neat cement 2 Cement grout (checked) 3 Bentonite 4 Other Grout Intervals: From +1 ft. to 12 ft., From ...

What is the nearest source of possible contamination: 1 Septic tank 2 Sewer lines 3 Watertight sewer lines 4 Lateral lines 5 Cess pool 6 Seepage pit 7 Pit privy 8 Sewage lagoon 9 Feedyard 10 Livestock pens 11 Fuel storage 12 Fertilizer storage 13 Insecticide storage 14 Abandoned water well (checked) 15 Oil well/Gas well 16 Other (specify below)

Direction from well? NORTH How many feet? 32'

Table with columns: FROM, TO, LITHOLOGIC LOG, FROM, TO, PLUGGING INTERVALS. Rows: 0-2 TOP SOIL, 2-12 SAND, GRAVEL, BROWN CLAY, 12-27 COARSE SAND, GRAVEL, 27-37 BLACK SHALE.

7 CONTRACTOR'S OR LANDOWNER'S CERTIFICATION: This water well was (1) constructed (checked), (2) reconstructed, or (3) plugged under my jurisdiction and was completed on (mo/day/year) 7-24-07 and this record is true to the best of my knowledge and belief. Kansas Water Well Contractor's License No. 633 This Water Well Record was completed on (mo/day/yr) 9-8-07 under the business name of DMW WELL PUMP SERVICE by signature Jerry W Wright

INSTRUCTIONS: Use typewriter or ball point pen. PLEASE PRESS FIRMLY and PRINT clearly. Please fill in blanks, underline or circle the correct answers. Send top three copies to Kansas Department of Health and Environment, Bureau of Water, Topeka, Kansas 66620-0001. Telephone: 913-296-5545. Send one to WATER WELL OWNER and retain one for your records.