


1 LOCATION OF WATER WELL: County: Wallace	Fraction NW 1/4 NW 1/4 NE 1/4	Section Number 5	Township Number T 13 S	Range Number R 39 EW
--	----------------------------------	---------------------	---------------------------	-------------------------

Distance and direction from nearest town or city street address of well if located within city?
 Approximately 4 miles north and 4 miles east of Sharon Springs

2 WATER WELL OWNER: Kansas Geological Survey
 RR#, St. Address, Box # : 1930 Constant Ave. Board of Agriculture, Division of Water Resources
 City, State, ZIP Code : Lawrence, KS 66045 Application Number:

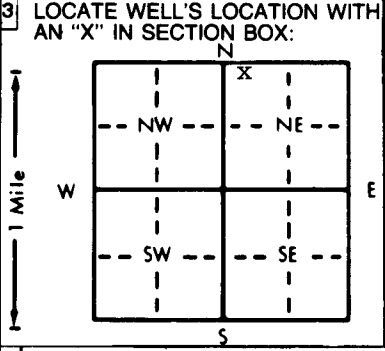

4 DEPTH OF COMPLETED WELL: 400 ft. ELEVATION: NA

Depth(s) Groundwater Encountered 1. NA ft. 2. NA ft. 3. NA ft.

WELL'S STATIC WATER LEVEL: NA ft. below land surface measured on mo/day/yr

Pump test data: Well water was NA ft. after NA hours pumping NA gpm

Est. Yield NA gpm: Well water was NA ft. after NA hours pumping NA gpm

Bore Hole Diameter: NA in. to NA ft., and NA in. to NA ft.

WELL WATER TO BE USED AS:

5 Public water supply	8 Air conditioning	11 Injection well
1 Domestic	3 Feedlot	6 Oil field water supply
2 Irrigation	4 Industrial	7 Lawn and garden only
		10 Monitoring well
		12 Other (Specify below)
		Observation

Was a chemical/bacteriological sample submitted to Department? Yes.....No.....; If yes, mo/day/yr sample was submitted

Water Well Disinfected? Yes No

5 TYPE OF BLANK CASING USED:

1 Steel	3 RMP (SR)	5 Wrought iron	8 Concrete tile	CASING JOINTS: Glued	Clamped
2 PVC	4 ABS	6 Asbestos-Cement	9 Other (specify below)	Welded	
		7 Fiberglass		Threaded	

Blank casing diameter 10 3/4" in. to NA ft. Dia. NA in. to NA ft. Dia. NA in. to NA ft.

Casing height above land surface 5' to 30' below ground level

TYPE OF SCREEN OR PERFORATION MATERIAL:

1 Steel	3 Stainless steel	5 Fiberglass	8 RMP (SR)	10 Asbestos-cement
2 Brass	4 Galvanized steel	6 Concrete tile	9 ABS	11 Other (specify) NA
				12 None used (open hole)

SCREEN OR PERFORATION OPENINGS ARE:

1 Continuous slot	3 Mill slot	5 Gauzed wrapped	8 Saw cut	11 None (open hole)
2 Louvered shutter	4 Key punched	6 Wire wrapped	9 Drilled holes	
		7 Torch cut	10 Other (specify) NA	

SCREEN-PERFORATED INTERVALS: From 999 ft. to 999 ft., From NA ft. to NA ft., From NA ft. to NA ft.

GRAVEL PACK INTERVALS: From NA ft. to NA ft., From NA ft. to NA ft., From NA ft. to NA ft.

6 GROUT MATERIAL: 1 Neat cement 2 Cement grout 3 Bentonite 4 Other Neat Cement and Bentonite

Grout Intervals: From NA ft. to NA ft., From NA ft. to NA ft., From NA ft. to NA ft., From NA ft. to NA ft., From NA ft. to NA ft.

What is the nearest source of possible contamination:

1 Septic tank	4 Lateral lines	7 Pit privy	10 Livestock pens	14 Abandoned water well
2 Sewer lines	5 Cess pool	8 Sewage lagoon	11 Fuel storage	15 Oil well/Gas well
3 Watertight sewer lines	6 Seepage pit	9 Feedyard	12 Fertilizer storage	16 Other (specify below)
			13 Insecticide storage	None known

Direction from well? How many feet?

FROM	TO	LITHOLOGIC LOG	FROM	TO	PLUGGING INTERVALS
			400	300	Caved in
			300	100	Chlorinated sand
		NOTE: ADVERSE DRILLING CONDITIONS WHILE DRILLING OBSERVATION WELL REQUIRED ABANDONING THE SITE.	100	95	Neat Cement
			95	37	Chlorinated sand
			37	5	Neat Cement and Bentonite
					Holeplug mixed
			5	0	Compacted fill dirt

7 CONTRACTOR'S OR LANDOWNER'S CERTIFICATION: This water well was (1) constructed, (2) reconstructed, or (3) plugged under my jurisdiction and was completed on (mo/day/year) 8-13-96 and this record is true to the best of my knowledge and belief. Kansas Water Well Contractor's License No. 185 This Water Well Record was completed on (mo/day/yr) 8-21-96 under the business name of Clarke Well & Equipment, Inc. by (signature) [Signature]

INSTRUCTIONS: Use typewriter or ball point pen. PLEASE PRESS FIRMLY and PRINT clearly. Please fill in blanks, underline or circle the correct answers. Send top three copies to Kansas Department of Health and Environment, Bureau of Water, Topeka, Kansas 66620-0001. Telephone: 913-296-5545. Send one to WATER WELL OWNER and retain one for your records.