


**WATER WELL RECORD Form WWC-5 KSA 82a-1212**

1 LOCATION OF WATER WELL: County: <u>Wallace</u>	Fraction <u>NE 1/4 NE 1/4 SW 1/4</u>	Section Number <u>27</u>	Township Number <u>T 13 S</u>	Range Number <u>R 39 EW</u>
---	---	-----------------------------	----------------------------------	--------------------------------

Distance and direction from nearest town or city street address of well if located within city?  
1 1/4 W 3/4 S of Wallace

2 WATER WELL OWNER: Myrtle Haislip  
 RR#, St. Address, Box #: HCR 1 Box 51  
 City, State, ZIP Code: Wallace, Kansas 67761  
 Board of Agriculture, Division of Water Resources  
 Application Number: \_\_\_\_\_

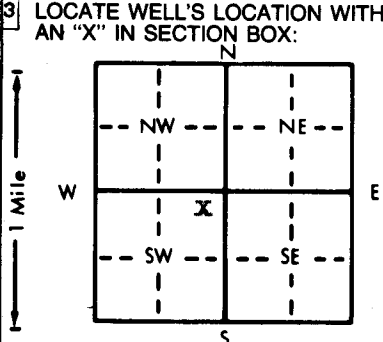

4 DEPTH OF COMPLETED WELL 80 ft. ELEVATION: \_\_\_\_\_  
 Depth(s) Groundwater Encountered 1 ft. 2. \_\_\_\_\_ ft. 3. \_\_\_\_\_ ft.  
 WELL'S STATIC WATER LEVEL 12 ft. below land surface measured on mo/day/yr 7-17-05  
 Pump test data: Well water was \_\_\_\_\_ ft. after \_\_\_\_\_ hours pumping \_\_\_\_\_ gpm  
 Est. Yield \_\_\_\_\_ gpm: Well water was not tested after \_\_\_\_\_ hours pumping \_\_\_\_\_ gpm  
 Bore Hole Diameter 5 in. to 00 ft., and \_\_\_\_\_ in. to \_\_\_\_\_ ft.  
 WELL WATER TO BE USED AS:  
 1 Domestic \_\_\_\_\_ 3 Feedlot \_\_\_\_\_ 6 Oil field water supply \_\_\_\_\_ 9 Dewatering \_\_\_\_\_ 12 Other (Specify below) \_\_\_\_\_  
 2 Irrigation \_\_\_\_\_ 4 Industrial \_\_\_\_\_ 7 Lawn and garden only \_\_\_\_\_ 10 Observation well \_\_\_\_\_  
 Was a chemical/bacteriological sample submitted to Department? Yes \_\_\_\_\_ No X; If yes, mo/day/yr sample was sub-  
 mitted \_\_\_\_\_ Water Well Disinfected? Yes X No \_\_\_\_\_

5 TYPE OF BLANK CASING USED:  
 1 Steel \_\_\_\_\_ 3 RMP (SR) \_\_\_\_\_ 5 Wrought iron \_\_\_\_\_ 8 Concrete tile \_\_\_\_\_ CASING JOINTS: Glued X Clamped \_\_\_\_\_  
 2 PVC \_\_\_\_\_ 4 ABS \_\_\_\_\_ 6 Asbestos-Cement \_\_\_\_\_ 9 Other (specify below) \_\_\_\_\_ Welded \_\_\_\_\_  
 7 Fiberglass \_\_\_\_\_ Threaded \_\_\_\_\_  
 Blank casing diameter 5 in. to 70 ft., Dia \_\_\_\_\_ in. to \_\_\_\_\_ ft., Dia \_\_\_\_\_ in. to \_\_\_\_\_ ft.  
 Casing height above land surface 10 in., weight 1.8/10 lbs./ft. Wall thickness or gauge No. SDR 21  
 TYPE OF SCREEN OR PERFORATION MATERIAL:  
 1 Steel \_\_\_\_\_ 3 Stainless steel \_\_\_\_\_ 5 Fiberglass \_\_\_\_\_ 7 PVC \_\_\_\_\_ 10 Asbestos-cement \_\_\_\_\_  
 2 Brass \_\_\_\_\_ 4 Galvanized steel \_\_\_\_\_ 6 Concrete tile \_\_\_\_\_ 8 RMP (SR) \_\_\_\_\_ 11 Other (specify) \_\_\_\_\_  
 9 ABS \_\_\_\_\_ 12 None used (open hole) \_\_\_\_\_  
 SCREEN OR PERFORATION OPENINGS ARE:  
 1 Continuous slot \_\_\_\_\_ 3 Mill slot \_\_\_\_\_ 5 Gauzed wrapped \_\_\_\_\_ 8 Saw cut \_\_\_\_\_ 11 None (open hole) \_\_\_\_\_  
 2 Louvered shutter \_\_\_\_\_ 4 Key punched \_\_\_\_\_ 6 Wire wrapped \_\_\_\_\_ 9 Drilled holes \_\_\_\_\_  
 7 Torch cut \_\_\_\_\_ 10 Other (specify) \_\_\_\_\_  
 SCREEN-PERFORATED INTERVALS: From 70 ft. to 80 ft., From \_\_\_\_\_ ft. to \_\_\_\_\_ ft.  
 From \_\_\_\_\_ ft. to \_\_\_\_\_ ft., From \_\_\_\_\_ ft. to \_\_\_\_\_ ft.  
 GRAVEL PACK INTERVALS: From 10 ft. to 80 ft., From \_\_\_\_\_ ft. to \_\_\_\_\_ ft.  
 From \_\_\_\_\_ ft. to \_\_\_\_\_ ft., From \_\_\_\_\_ ft. to \_\_\_\_\_ ft.

6 GROUT MATERIAL: 1 Neat cement 2 Cement grout 3 Bentonite 4 Other \_\_\_\_\_  
 Grout Intervals: From 4 ft. to 10 ft., From \_\_\_\_\_ ft. to \_\_\_\_\_ ft., From \_\_\_\_\_ ft. to \_\_\_\_\_ ft.  
 What is the nearest source of possible contamination:  
 1 Septic tank \_\_\_\_\_ 4 Lateral lines \_\_\_\_\_ 7 Pit privy \_\_\_\_\_ 10 Livestock pens \_\_\_\_\_ 14 Abandoned water well \_\_\_\_\_  
 2 Sewer lines \_\_\_\_\_ 5 Cess pool \_\_\_\_\_ 8 Sewage lagoon \_\_\_\_\_ 11 Fuel storage \_\_\_\_\_ 15 Oil well/Gas well \_\_\_\_\_  
 3 Watertight sewer lines \_\_\_\_\_ 6 Seepage pit \_\_\_\_\_ 9 Feedyard \_\_\_\_\_ 12 Fertilizer storage \_\_\_\_\_ 16 Other (specify below) \_\_\_\_\_  
 13 Insecticide storage \_\_\_\_\_ pasture \_\_\_\_\_  
 Direction from well? \_\_\_\_\_ How many feet? \_\_\_\_\_

FROM	TO	LITHOLOGIC LOG	FROM	TO	LITHOLOGIC LOG
0	7	top soil			
7	60	sand			
60	62	sand rock			
62	79	sand			
79	80	shale			

7 CONTRACTOR'S OR LANDOWNER'S CERTIFICATION: This water well was (1) constructed, (2) reconstructed, or (3) plugged under my jurisdiction and was completed on (mo/day/year) 7-17-05 and this record is true to the best of my knowledge and belief. Kansas Water Well Contractor's License No. 139 This Water Well Record was completed on (mo/day/yr) 9-23-05 under the business name of Bartell Drilling by (signature) Joyce Bartell

INSTRUCTIONS: Use typewriter or ball point pen, PLEASE PRESS FIRMLY and PRINT clearly. Please fill in blank, underline or circle the correct answers. Send top three copies to Kansas Department of Health and Environment, Division of Environment, Environmental Geology Section, Topeka, KS 66620. Send one to WATER WELL OWNER and retain one for your records.