

NE well

WATER WELL RECORD

Form WWC-5


Division of Water Resources App. No.

48934

1 LOCATION OF WATER WELL: County: Saline Fraction NW 1/4 SE 1/4 NE 1/4 NW 1/4 Section Number 2 Township No. T 13 S Range Number R 4 [] E [x] W

Street/Rural Address of Well Location; if unknown, distance & direction from nearest town or intersection: If at owner's address, check here [] From Salina on I-70 6W 5N 1E Global Positioning System (GPS) information: Latitude: 38.95639 Longitude: 097.73475 Elevation: 1262

2 WATER WELL OWNER: Gotti Farms, Grant Gotti RR#, Street Address, Box #: 10 N. 100th Rd. City, State, ZIP Code : Culver, Kansas 67484 Collection Method: [x] GPS unit (Make/Model: Garmin 62S) [] Digital Map/Photo, [x] Topographic Map, [] Land Survey Est. Accuracy: [] <3 m, [x] 3-5 m, [] 5-15 m, [] >15 m

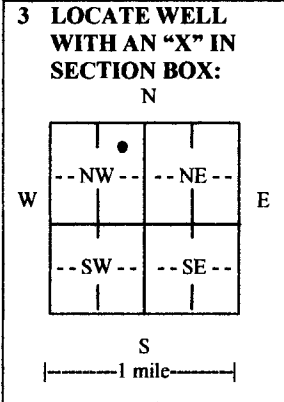

3 LOCATE WELL WITH AN 'X' IN SECTION BOX: 4 DEPTH OF COMPLETED WELL 53 ft. Depth(s) Groundwater Encountered (1)..... ft. (2)..... ft. (3)..... ft. WELL'S STATIC WATER LEVEL 22 ft. below land surface measured on mo/day/yr. 3/24/2015 Pump test data: Well water was.....ft. after..... hours pumping..... gpm EST. YIELD.....gpm. Well water was.....ft. after..... hours pumping..... gpm Bore Hole Diameter 16.....in. to 53..... ft., andin. to ft. WELL WATER TO BE USED AS: [] Public water supply [] Geothermal [] Injection well [] Domestic [] Feedlot [] Oil field water supply [] Dewatering [] Other (Specify below) [x] Irrigation [] Industrial [] Domestic-lawn & garden [] Monitoring well Was a chemical/bacteriological sample submitted to Department? [] Yes [x] No If yes, mo/day/yr sample was submitted..... Water well disinfected? [x] Yes [] No

5 TYPE OF CASING USED: [] Steel [x] PVC [] Other CASING JOINTS: [x] Glued [] Clamped [] Welded [] Threaded Bolted Casing diameter 8..... in. to 38..... ft., Diameter in. to ft., Diameter in. to ft. Casing height above land surface 16..... in., Weight 160..... lbs./ft., Wall thickness or gauge No. 332 TYPE OF SCREEN OR PERFORATION MATERIAL: [] Steel [x] Stainless Steel [] PVC [] Other (Specify) [] Brass [] Galvanized Steel [] None used (open hole) SCREEN OR PERFORATION OPENINGS ARE: [] Continuous slot [] Mill slot [] Gauze wrapped [] Torch cut [] Drilled holes [] None (open hole) [] Louvered shutter [] Key punched [x] Wire wrapped [] Saw cut [] Other (specify) SCREEN-PERFORATED INTERVALS: From 38..... ft. to 53..... ft., From ft. to ft. GRAVEL PACK INTERVALS: From 53..... ft. to 20..... ft., From ft. to ft.

6 GROUT MATERIAL: [] Neat cement [] Cement grout [x] Bentonite [] Other Grout Intervals: From 20..... ft. to 0..... ft., From ft. to ft., From ft. to ft. What is the nearest source of possible contamination: [] Septic tank [] Lateral lines [] Pit privy [] Livestock pens [] Insecticide storage [x] Other (specify below) [] Sewer lines [] Cesspool [] Sewage lagoon [] Fuel storage [] Abandoned water well [] Watertight sewer lines [] Seepage pit [] Feedyard [] Fertilizer storage [] Oil well/gas well SE Irrigation well Direction from well South Distance from well 280

Table with 6 columns: FROM, TO, LITHOLOGIC LOG, FROM, TO, LITHO. LOG (cont.) or PLUGGING INTERVALS. Rows include: 0-3 Top soil, 3-6 Brown clay, 6-20 Tan clay-sandy, 20-30 Fine-small sand, 30-35 Bluish-green clay-soft, 35-46 Fine-med. sand, 46-53 Bluish-green & red shale.

7 CONTRACTOR'S OR LANDOWNER'S CERTIFICATION: This water well was [x] constructed, [] reconstructed, or [] plugged under my jurisdiction and was completed on (mo/day/year) 3/24/2015 and this record is true to the best of my knowledge and belief. Kansas Water Well Contractor's License No. 134 This Water Well Record was completed on (mo/day/year) 3/30/2015 under the business name of Rosencrantz-Bemis Ent. by (signature) [Signature]

INSTRUCTIONS: Use typewriter or ball point pen. PLEASE PRESS FIRMLY and PRINT clearly. Please fill in blanks and check the correct answers. Send three copies (white, blue, pink) to Kansas Department of Health and Environment, Bureau of Water, Geology Section, 1000 SW Jackson St., Suite 420, Topeka, Kansas 66612-1367. Telephone 785-296-5524. Send one copy to WATER WELL OWNER and retain one for your records. Include fee of \$5.00 for each constructed well. Visit us at http://www.kdheks.gov/waterwell/index.html.