USE TYPEWRITER OR BALL POINT PEN-PRESS FIRMLY, PRINT CLEARLY.

WATER WELL RECORD
KSA 82a-1201-1215

Kansas Department of Health and Environment-Division of Environment
(Water well Contractors)
Topeka, Kansas 66620

1. Location of well:	County	Fraction	Section number	Township number	Range number
	Saline	SW 1/4 NE 1/4 NE 1/4	7	T 13 S	R 4W E/W

2. Distance and direction from nearest town or city: 2 mi S + 2 mi W Culver
Street address of well location if in city:

3. Owner of well: Allen E Smith
R.R. or street: Rt 2 Box 49
City, state, zip code: Salina Kans 67401

4. Locate with "X" in section below:

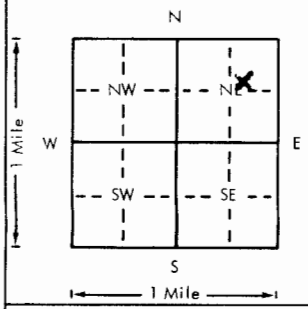

Sketch map:

6. Bore hole dia. 4 in. Completion date
Well depth 69 ft. 9/18/78

7. __ Cable tool X Rotary __ Driven __ Dug
__ Hollow rod __ Jetted __ Bored __ Reverse rotary

8. Use: X Domestic __ Public supply __ Industry
__ Irrigation __ Air conditioning __ Stock
__ Lawn __ Oil field water __ Other

9. Casing: Material
Threaded ___ Welded ___
RMP X PVC ~~X~~
Dia. 4 in. to 69 ft. depth
Dia. ___ in. to ___ ft. depth
Height: Above or below Surface 12 in.
Weight ___ lbs./ft.
Wall Thickness: inches or gage No. 200

10. Screen: Manufacturer's name Shop
Type slots Dia. 4"
Slot/gauze 1/16" Length 40'
Set between 29 ft. and 69 ft.
___ ft. and ___ ft.
Gravel pack? X Size range of material 1/10"

11. Static water level:
23 ft. below land surface Date 9/18/78 mo./day/yr.

12. Pumping level below land surfaces:
ND ft. after 1/2 hrs. pumping 7 g.p.m.
___ ft. after ___ hrs. pumping ___ g.p.m.
Estimated maximum yield 9 g.p.m.

13. Water sample submitted: mo./day/yr.
__ Yes X No Date

14. Well head completion:
__ Pitless adapter 12 Inches above grade

15. Well grouted? Y
With: X Neat cement __ Bentonite __ Concrete
Depth: From 3 ft. to 13 ft.

16. Nearest source of possible contamination:
ft. Open Pasture Type
Well disinfected upon completion? X Yes __ No

17. Pump: X Not installed
Manufacturer's name
Model number HP Volts
Length of drop pipe ft. capacity g.p.m.
Type:
__ Submersible __ Turbine
__ Jet __ Reciprocating
__ Centrifugal __ Other

5. Type and color of material	From	To
Soil	0	1
Kiowa:		
Shale, yellow-gray	1	9
Sandstone, fine	9	14
Shale, gray	14	26
Sandstone, fine	26	34
Shale, gray + siltstone	34	54
Siltstone, sandstone, very fine + shale	54	74
Shale, dark gray	74	108
Ninnescah Shale:		
Shale, gray + red	108	111

(Use a second sheet if needed)

18. Elevation:

Topography:
__ Hill
__ Slope
X Upland
__ Valley

19. Remarks:

20. Water well contractor's certification:
This well was drilled under my jurisdiction and this report is true to the best of my knowledge and belief.
Hydraulic Drilling Co 126
Business name License No.
Address Salina Kans
Signed [signature] Date 10/5/78
Authorized representative

T 13 R 4 W Sec 7 1/4 1/4 1/4 SW NE NE

Forward the white, blue and pink copies to the Department of Health and Environment

Form WWC-5

MI-1023