



NOTE: Figures exhibited within this report are only to be used within the context of this report. Placement of property lines, wells, structures, and roads is based on the available information from county appraiser maps, surveys, site visits, and/or previous vendor reports and should be considered approximate.

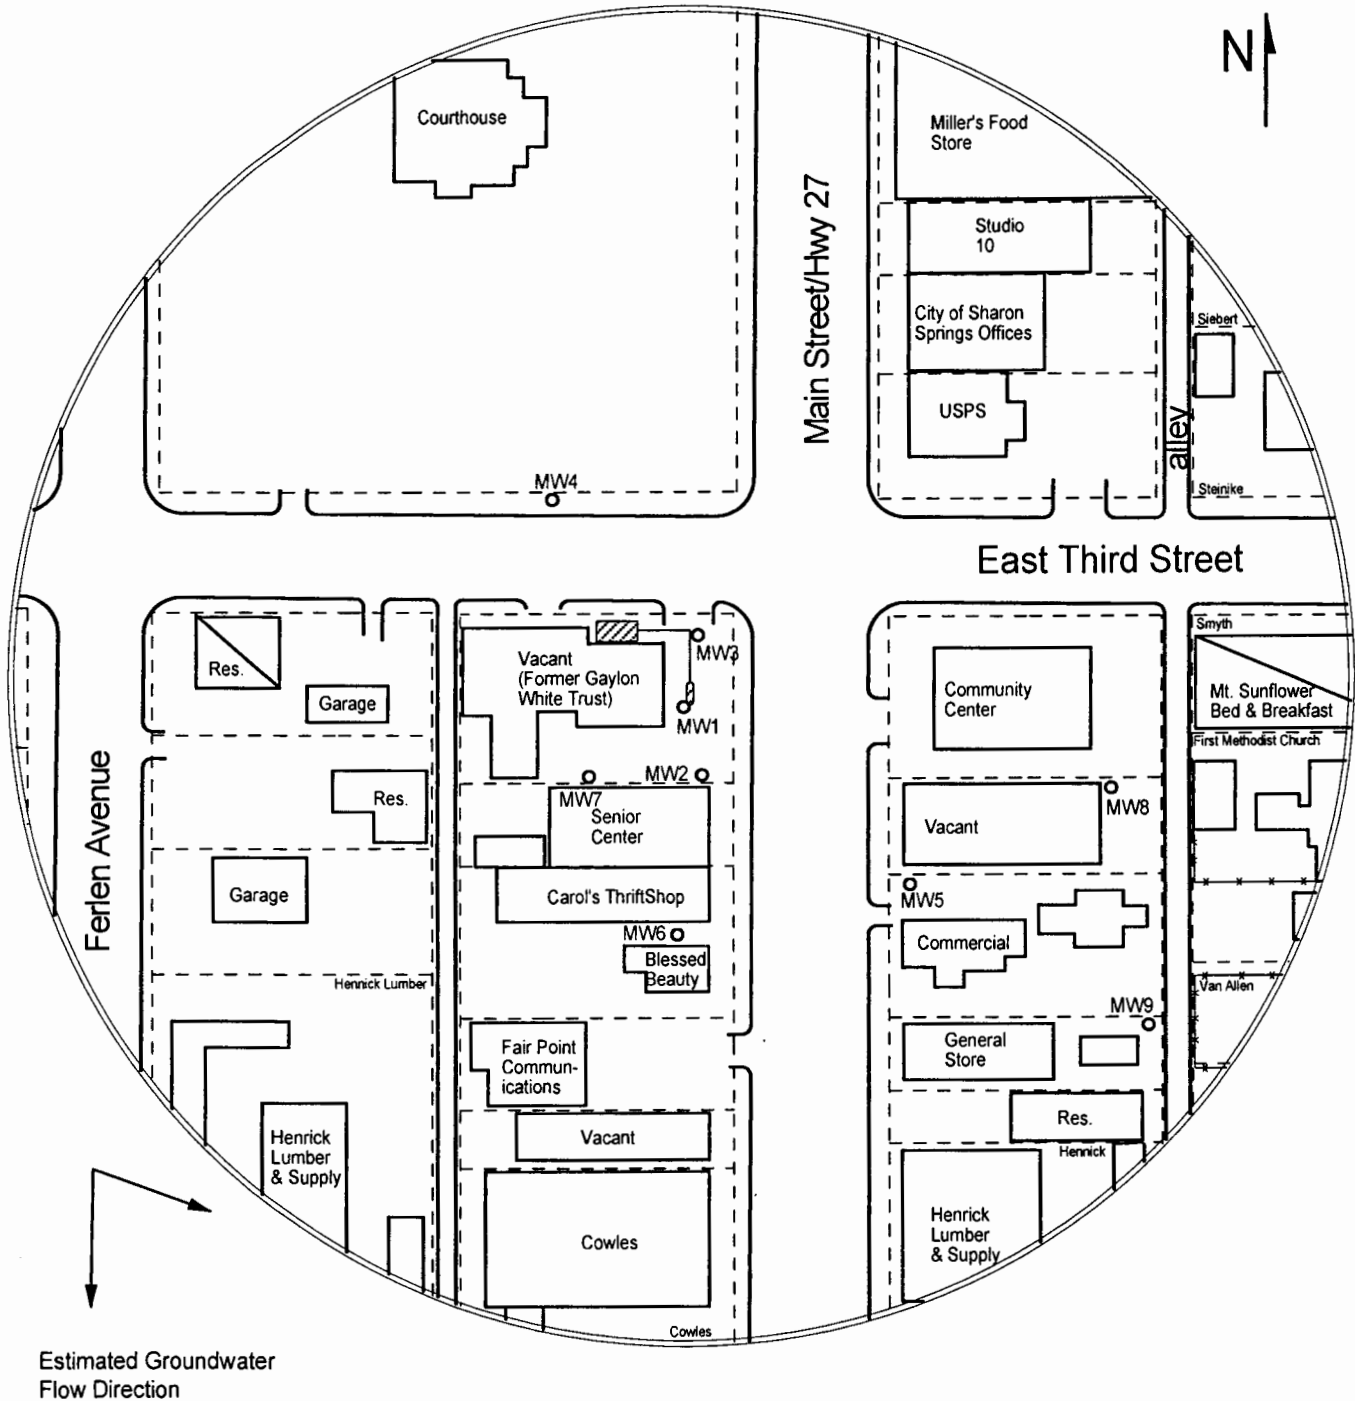


FIGURE 1 - 350 FT RADIUS AREA BASE MAP

**LEGEND:**

- Approximate Location of Former UST Basin & Pump Island
- Building with Basement
- Approximate Location of Property Line
- Plugged Monitoring Well

*Sec. 27 T. 13 R. 36.40W  
Warrick*



**PROJECT:**

Gaylon White Trust  
227 N. Main Street  
Sharon Springs, KS  
KDHE ID: U6-100-13250  
Date: 11/1/22

1311 E 25th St. Suite B 785-841-8707 office  
Lawrence, KS 66046 785-865-4282 fax



NOTE: Utility depths, heights and locations are approximate.