


|   |                             |                      |                           |   |
|---|-----------------------------|----------------------|---------------------------|---|
| <b>1 LOCATION OF WATER WELL:</b><br>County: Wallace | Fraction<br>SW¼ NE¼ SE¼ NW¼ | Section Number<br>27 | Township Number<br>T 13 S | Range Number<br>40 <input type="checkbox"/> E <input checked="" type="checkbox"/> W |
|---|-----------------------------|----------------------|---------------------------|---|

Street/Rural Address of Well Location; if unknown, distance & direction from nearest town or intersection: If at owner's address, check here   
227 N Main St, Sharon Springs, KS

**Global Positioning Systems (GPS) information:**  
 Latitude: 38.89722 (in decimal degrees)  
 Longitude: -101.75192 (in decimal degrees)  
 Elevation: \_\_\_\_\_  
 Horizontal Datum  WGS84,  NAD83,  NAVD27  
 Collection Method:  
 GPS unit (Make/model: \_\_\_\_\_)  
 Digital Map/Photo,  Topographic Map  Land Survey  
 Est. Accuracy:  <3 m,  3-5 m,  5-15 m,  >15 m

**2 WATER WELL OWNER:** Gaylon White Trust  
 RR#, St. Address, Box #: P.O. Box 111  
 City, State ZIP Code: Arapahoe, CO 80802

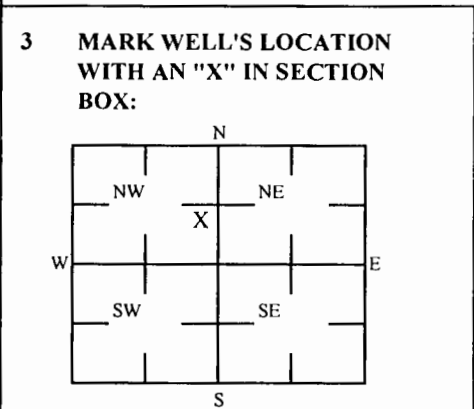

**4 DEPTH OF WELL** 30.75 ft. MW3  
 WELL'S STATIC WATER LEVEL \_\_\_\_\_ ft  
 WELL WAS USED AS:  
 Domestic  Public Water Supply  Dewatering  
 Irrigation  Oil Field Water Supply  Monitoring  
 Feedlot  Domestic (Lawn & Garden)  Injection Well  
 Industrial  Air Conditioning  Other \_\_\_\_\_  
 Was a chemical/bacteriological sample submitted to Department? Yes  No

**5 TYPE OF BLANK CASING USED:**

|   |                                   |  |  |   |
|---|-----------------------------------|--|--|---|
| <input type="checkbox"/> Steel          | <input type="checkbox"/> RMP (SR) | <input type="checkbox"/> Wrought         | <input type="checkbox"/> Fiberglass    | <input type="checkbox"/> Other (Specific below) |
| <input checked="" type="checkbox"/> PVC | <input type="checkbox"/> ABS      | <input type="checkbox"/> Asbestos-Cement | <input type="checkbox"/> Concrete Tile | _____   |

Blank casing diameter 2 in. Was casing pulled? Yes  No  If yes, how much 3 ft  
 Casing height above or below land surface NA in.

**6 GROUT PLUG MATERIAL:**  Neat cement  Cement grout  Bentonite  Other Concrete: 0-0.5'; Soil: 0.5-3'

Grout Plug Intervals: From 3 ft to 30.75 ft, From \_\_\_\_\_ ft to \_\_\_\_\_ ft, From \_\_\_\_\_ ft to \_\_\_\_\_ ft.

What is the nearest source of possible contamination:  
 Septic tank  Seepage pit  Fuel storage  Other (specify below) \_\_\_\_\_  
 Sewer lines  Pit privy  Fertilizer storage \_\_\_\_\_  
 Watertight sewer lines  Sewage lagoon  Insecticide storage \_\_\_\_\_  
 Lateral lines  Feed yard  Abandoned water well Direction from well? \_\_\_\_\_  
 Cess pool  Livestock pens  Oil well/Gas well How many feet? \_\_\_\_\_

| FROM                                      | TO    | PLUGGING MATERIALS | FROM | TO | PLUGGING MATERIALS |
|---|-------|--------------------|------|----|--------------------|
| 0   | 0.5   | Concrete           |      |    |                    |
| 0.5                                       | 3     | Soil               |      |    |                    |
| 3   | 30.75 | Bentonite          |      |    |                    |
|   |       |                    |      |    |                    |
| KDHE ID: Gaylon White Trust; U6-100-13250 |       |                    |      |    |                    |

**7 CONTRACTOR'S OR LANDOWNER'S CERTIFICATION:** This water well was plugged under my jurisdiction and was completed on (mo/day/year) 11/1/22 and this record is true to the best of my knowledge and belief. Kansas Water Contractor's License No. 757. This Water Well Record was completed on (mo/day/year) 11/7/22 under the business name of Larsen & Associates, Inc. By (signature) \_\_\_\_\_

Send one white copy to Kansas Department of Health & Environment, Geology Section, 1000 SW Jackson Street, Ste. 420/Topeka, KS 66612-1367. Send one copy to WATER WELL OWNER and retain one for your records  
 Visit us at <http://www.kdheks.gov/waterwell/index.html> Telephone 785-296-5524.

NOTE: Figures exhibited within this report are only to be used within the context of this report. Placement of property lines, wells, structures, and roads is based on the available information from county appraiser maps, surveys, site visits, and/or previous vendor reports and should be considered approximate.

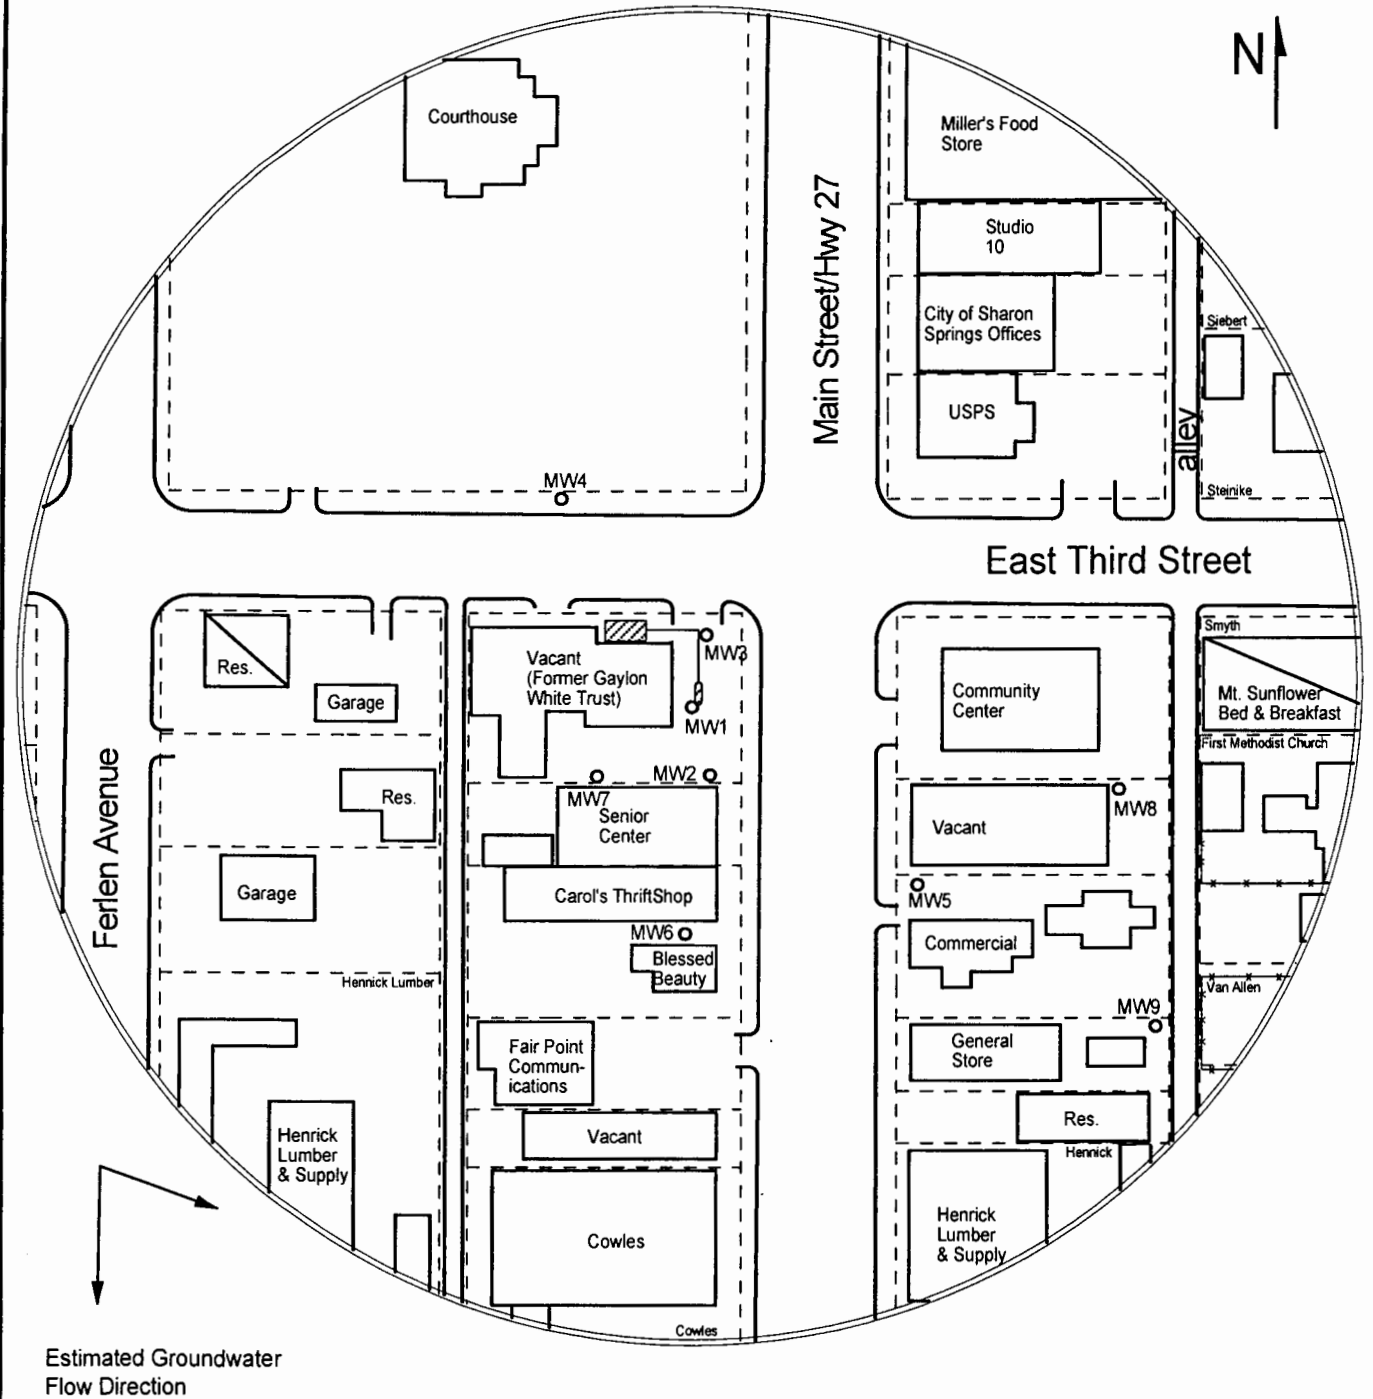


FIGURE 1 - 350 FT RADIUS AREA BASE MAP



**PROJECT:**

Gaylon White Trust  
 227 N. Main Street  
 Sharon Springs, KS  
 KDHE ID: U6-100-13250  
 Date: 11/1/22

**LEGEND:**

- Approximate Location of Former UST Basin & Pump Island
- Building with Basement
- Approximate Location of Property Line
- Plugged Monitoring Well

*Sec. 27 T. 13 R. 40W  
 Wallace*

1311 E 25th St. Suite B 785-841-8707 office  
 Lawrence, KS 66046 785-865-4282 fax



NOTE: Utility depths, heights and locations are approximate.