

NOTE: Figures exhibited within this report are only to be used within the context of this report. Placement of property lines, wells, structures, and roads is based on the available information from county appraiser maps, surveys, site visits, and/or previous vendor reports and should be considered approximate.

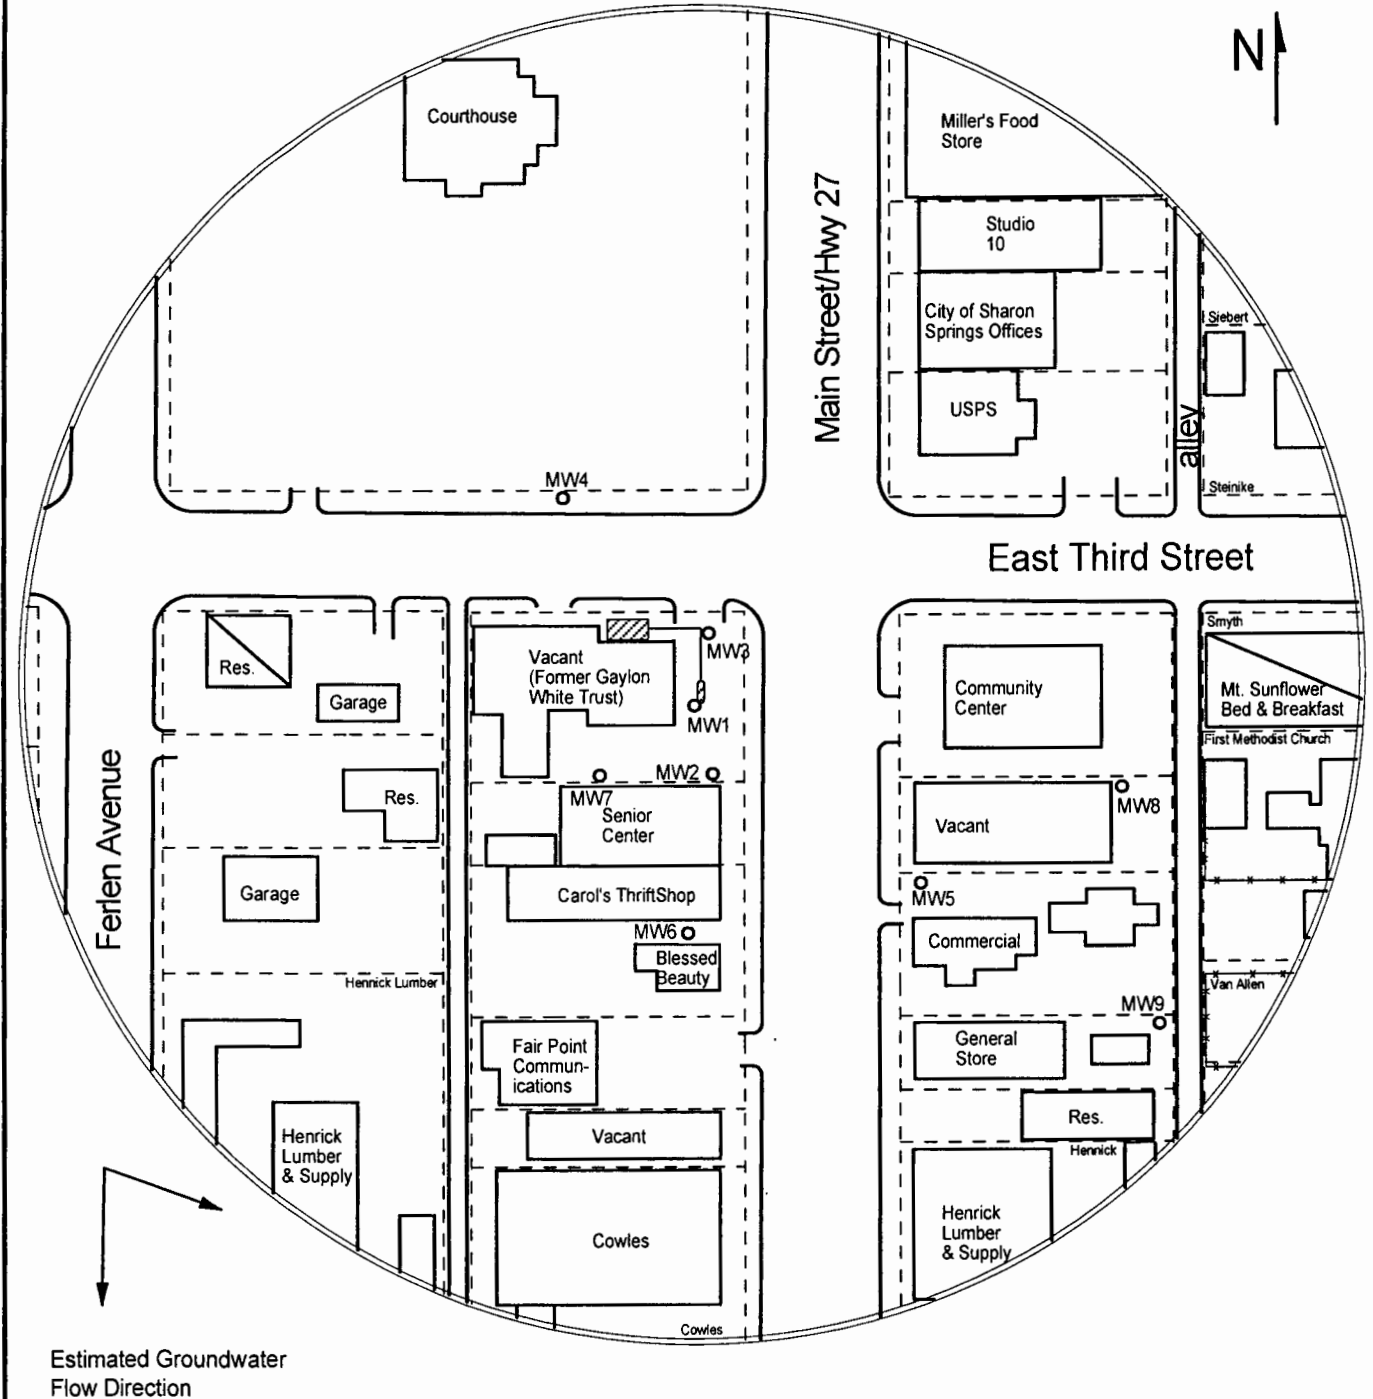


FIGURE 1 - 350 FT RADIUS AREA BASE MAP



1311 E 25th St. Suite B
Lawrence, KS 66046

785-841-8707 office
785-865-4282 fax

PROJECT:

Gaylon White Trust
227 N. Main Street
Sharon Springs, KS
KDHE ID: U6-100-13250
Date: 11/1/22



LEGEND:

- Approximate Location of Former UST Basin & Pump Island
- Building with Basement
- Approximate Location of Property Line
- Plugged Monitoring Well

*Sec. 27 T. 13 R. 36.40W
Wanace*

NOTE: Utility depths, heights and locations are approximate.