

County: Wallace Fraction: SW NW NW NE Sec. 27 T. 13 S R. 40 W

**CORRECTION(S) to WATER WELL COMPLETION RECORD Form WWC-5 (to rectify lacking or incorrect information)**

Owner: Tokoi, Carol Monitoring

If location corrected, was listed as:

Location changed to:

Section-Township-Range: \_\_\_\_\_

\_\_\_\_\_

Fraction (1/4 calls): \_\_\_\_\_

\_\_\_\_\_

Other changes: Initial statements: Well Contractor License No. 735

Changed to: Well Contractor License No. 881

Comments: Well Contractor License No. changed to 881 to match with Woofter Pump and Well

Verification method: Confirmed by Milco Env. Srvs. via Pam Chaffee

Submitted by: \_\_\_\_\_ Initials: RS Date: 03/11/2024

- Submitted by:  Kansas Geological Survey, Data Resources Library, 1930 Constant Ave., Lawrence, KS 66047-3724  
 Kansas Dept. of Health & Environment, Bureau of Water, 1000 SW Jackson, Suite 420, Topeka, KS 66612-1367

WATER WELL RECORD Form WWC-5

Division of Water Resources App. No.

[ ]

MW-14

Original Record Correction Change in Well Use

Well ID

1 LOCATION OF WATER WELL: County: Wallace Fraction SW 1/4 NW 1/4 NW 1/4 NE 1/4 Section Number 27 Township Number T 13 S Range Number R 40 E W

2 WELL OWNER: Last Name: Tokoi First: Carol Street or Rural Address where well is located (if unknown, distance and direction from nearest town or intersection): If at owner's address, check here: 515 N. Boeke St. in Sharon Springs, approx. 18' east of alley

3 LOCATE WELL WITH 'X' IN SECTION BOX: N W E S 1 mile 4 DEPTH OF COMPLETED WELL: 40 ft. 5 Latitude: 38.900299 Longitude: -101.749677

7 WELL WATER TO BE USED AS: 1. Domestic: 2. Irrigation 3. Feedlot 4. Industrial 5. Public Water Supply 6. Dewatering 7. Aquifer Recharge 8. Monitoring MW-14 9. Environmental Remediation 10. Oil Field Water Supply 11. Test Hole 12. Geothermal 13. Other

Was a chemical/bacteriological sample submitted to KDHE? Water well disinfected?

8 TYPE OF CASING USED: Steel PVC Other CASING JOINTS: Glued Clamped Welded Threaded Casing diameter 2 in. to 25 ft. Diameter in. to ft. Diameter in. to ft. Casing height above land surface -3 in. Weight 0.68 lbs./ft. Wall thickness or gauge No. 0.154

9 GROUT MATERIAL: Neat cement Cement grout Bentonite Other Grout Intervals: From 1 ft. to 22 ft. From ft. to ft. From ft. to ft.

Nearest source of possible contamination: Septic Tank Lateral Lines Pit Privy Livestock Pens Insecticide Storage Sewer Lines Cess Pool Sewage Lagoon Fuel Storage Abandoned Water Well Watertight Sewer Lines Seepage Pit Feedyard Fertilizer Storage Oil Well/Gas Well Other (Specify)

Table with 6 columns: 10 FROM, TO, LITHOLOGIC LOG, FROM, TO, LITHO. LOG (cont.) or PLUGGING INTERVALS. Rows: 0-15 Silt, 15-25 Clay, 25-40 Shale, clayey, highly weathered with hard, brittle layers after 38.5'

11 CONTRACTOR'S OR LANDOWNER'S CERTIFICATION: This water well was constructed, reconstructed, or plugged under my jurisdiction and was completed on (mo-day-year) 1/26/2023 and this record is true to the best of my knowledge and belief. Kansas Water Well Contractor's License No. 735 This Water Well Record was completed on (mo-day-year) 3/23/2023 under the business name of Wootter Pump and Well Signature


PLOTTED: 3/7/2023 1:57 PM      SAVED: 12/5/2022 2:52 PM      G:\Projects\437\437-P1-02\Semi-annual 3-2023\Figure A.dwg



**LEGEND**

- MONITORING WELL
- PLUGGED WELL
- FORMER UST BASIN
- FORMER PUMP ISLAND/PRODUCT LINES

T. 13 Rge. 40W Sec. 27  
 Wallace County  
 KDHE: Shamrock Service  
 U6-100-00704

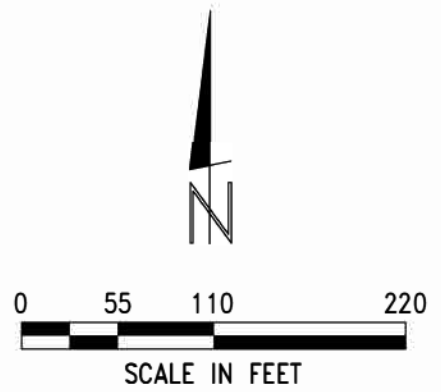

REVISIONS	BY
<p><b>MILCO</b>                      Environmental                      Services, Inc.                      Kearney, NE (308) 237-5923                      McCook, NE (308) 345-4741</p>	
<p><b>SHAMROCK SERVICE</b>  <b>SITE MAP</b>                      612 N. MAIN STREET - SHARON SPRINGS, KANSAS U6-100-00704</p>	
<p><small>This document, and the ideas and designs incorporated herein, are an instrument of professional service, is the property of MILCO and is not to be used in whole or in part, for any other project without the written authorization of © 2009 MILCO.</small></p>	
<p>SCALE: AS SHOWN                      PROJECT NO. M437-P1-02                      DATE: MARCH, 2023                      FIELD BOOK: M&amp;A DWG NO.                      DRAWN BY: TWB                      SHEET</p>	<p>APRVD BY:</p>
<p><b>FIGURE A</b></p>	