

LOCATION OF WATER WELL: County: WALLACE	Fraction NE 1/4 NE 1/4 NW 1/4	Section Number 34	Township Number T 13 S	Range Number R 40 EW
---	---	-----------------------------	----------------------------------	--------------------------------


Distance and direction from nearest town or city street address of well if located within city?
30' E of SE corner of Wallace City Coop Station Bldg. on S Hwy 27 **MW-1**

WATER WELL OWNER: **WALLACE City COOP - Fred Nowak**

RR#, St. Address, Box #: **South Hwy 27**

City, State, ZIP Code: **Sharon Springs, KS 67258**

Board of Agriculture, Division of Water Resources
Application Number:

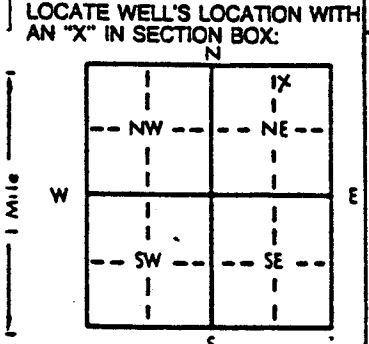

DEPTH OF COMPLETED WELL: **25.0** ft. ELEVATION:

Depth(s) Groundwater Encountered 1. **1.8** ft. 2. ft. 3. ft.

WELL'S STATIC WATER LEVEL **17.25** ft. below land surface measured on mo/day/yr **4/2/95**

Pump test data: Well water was ft. after hours pumping gpm

Est. Yield gpm: Well water was ft. after hours pumping gpm

Bore Hole Diameter: **4.25** in. to **2.5** ft., and in. to ft.

WELL WATER TO BE USED AS:

5 Public water supply	8 Air conditioning	11 Injection well
1 Domestic	3 Feedlot	6 Oil field water supply
2 Irrigation	4 Industrial	7 Lawn and garden only
		<input checked="" type="checkbox"/> 10 Monitoring well
		12 Other (Specify below)

Was a chemical/bacteriological sample submitted to Department? Yes No ; If yes, mo/day/yr sample was submitted

Water Well Disinfected? Yes No

TYPE OF BLANK CASING USED:

1 Steel	3 RMP (SR)	6 Asbestos-Cement	9 Other (specify below)
<input checked="" type="checkbox"/> 2 PVC	4 ABS	7 Fiberglass	

CASING JOINTS: Glued Clamped
 Welded
 Threaded

Blank casing diameter **2** in. to **15.0** ft., Dia in. to ft., Dia in. to ft.

Casing height above land surface **0** in., weight lbs./ft. Wall thickness or gauge No.

TYPE OF SCREEN OR PERFORATION MATERIAL:

1 Steel	3 Stainless steel	5 Fiberglass	<input checked="" type="checkbox"/> 7 PVC	10 Asbestos-cement
2 Brass	4 Galvanized steel	6 Concrete tile	8 RMP (SR)	11 Other (specify)
			9 ABS	12 None used (open hole)

SCREEN OR PERFORATION OPENINGS ARE:

1 Continuous slot	<input checked="" type="checkbox"/> 3 Mill slot	5 Gauzed wrapped	8 Saw cut	11 None (open hole)
2 Louvered shutter	4 Key punched	6 Wire wrapped	9 Drilled holes	
		7 Torch cut	10 Other (specify)	

SCREEN-PERFORATED INTERVALS: From **25** ft. to **15** ft., From ft. to ft.

GRAVEL PACK INTERVALS: From **25** ft. to **14** ft., From ft. to ft.

GROUT MATERIAL: 1 Neat cement 2 Cement grout 3 Bentonite 4 Other

Grout intervals: From **14** ft. to **12** ft., From **12** ft. to **1.5** ft., From ft. to ft.

What is the nearest source of possible contamination:

1 Septic tank	4 Lateral lines	7 Pit privy	<input checked="" type="checkbox"/> 10 Fuel storage	14 Abandoned water well
2 Sewer lines	5 Cess pool	8 Sewage lagoon	12 Fertilizer storage	15 Oil well/Gas well
3 Watertight sewer lines	6 Seepage pit	9 Feedyard	13 Insecticide storage	16 Other (specify below)

Direction from well? **NW**

FROM	TO	LITHOLOGIC LOG	FROM	TO	PLUGGING INTERVALS
0.0'	0.5'	Concrete			
0.5'	7.0'	Silty clay, dark brown, black stain Petroleum odor			
7.0'	15.0'	Lt. Brown clayey silt, strong gas odor			
15.0'	25.0'	Brown sandy silt, strong gas odor, wet at 18'			

RECEIVED
JUN 25 1995
BUREAU OF WATER

CONTRACTOR'S OR LANDOWNER'S CERTIFICATION: This water well was constructed, reconstructed, or plugged under my jurisdiction and was completed on (mo/day/year) **3/27/95** and this record is true to the best of my knowledge and belief. Kansas Water Well Contractor's License No. **438** This Water Well Record was completed on (mo/day/yr) **5/18/95** under the business name of **Kansas City Testing Labs** by (signature) *[Signature]*