

USE TYPEWRITER OR BALL POINT PEN-PRESS FIRMLY, PRINT CLEARLY.

WATER WELL RECORD
KSA 82a-1201-1215


CBD

weskan NW

Kansas Department of Health and Environment-Division of Environment (Water well Contractors) Topeka, Kansas 66620

1. Location of well: County **wallace** Fraction **SE 1/4 NW 1/4 SW 1/4** Section number **31** Township number **13** Range number **41 E/W**

2. Distance and direction from nearest town or city: **3 1/2 east-south of weskan, Kansas**
Street address of well location if in city:
3. Owner of well: **Micheal holland**
R.R. or street: **russell, Kansas**
City, state, zip code:

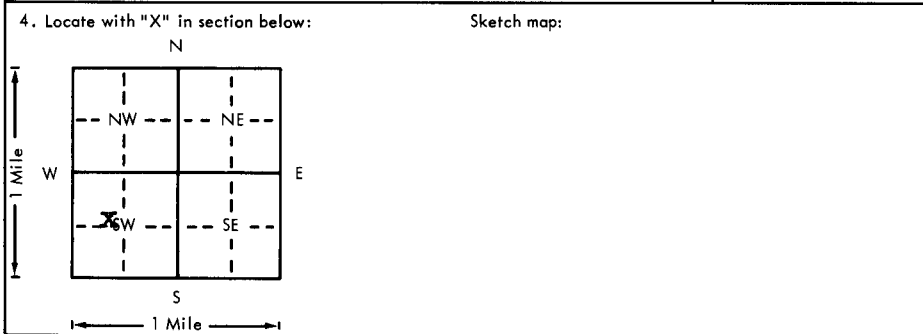

6. Bore hole dia. **8** in. Completion date **5/31/77**
Well depth **165** ft.

7. Cable tool Rotary Driven Aug
 Hollow rod Jetted Bored Reverse rotary

8. Use: Domestic Public supply Industry
 Irrigation Air conditioning Stock
 Lawn Oil field water Other

9. Casing: Material **plst** Height: Above or below
Threaded Welded **gl** Surface **15** in.
RMP PVC Weight lbs./ft.
Dia. **5** in. to **165** ft. depth Wall Thickness: inches or
Dia. in. to ft. depth Gage Ng. **1/4"**

5. Type and color of material	From	To
Top soil	0	41
sand	41	47
sand clay	47	65
sand	65	69
Sand Clay	69	74
Sand	74	91
Sand and sand rock strips	91	140
sand	140	145
sandy Clay	145	152
Sand	152	161
Oker and shale	161	163
Shale	163	165
BROCK 161'		
(Use a second sheet if needed)		

10. Screen: Manufacturer's name **J and L**

Type **RMP** Dia. **5"**
Slot/gauze **.032** Length **20**
Set between **145** ft. and **165** ft.
ft. and ft.
Gravel pack? **yes** Size range of material **1/8"**

11. Static water level: mo./day/yr.
130 ft. below land surface Date **5/31/77**

12. Pumping level below land surfaces:
 ft. after **na** hrs. pumping g.p.m.
 ft. after hrs. pumping g.p.m.
Estimated maximum yield g.p.m.

13. Water sample submitted: mo./day/yr.
 Yes No Date

14. Well head completion:
yes flatless adapter **20** inches above grade

15. Well grouted? **yes**
With: Neat cement Bentonite Concrete
Depth: From **4** ft. to **16** ft.

16. Nearest source of possible contamination:
ft. Direction **NA** Type
Well disinfected upon completion? Yes No

17. Pump: Not installed
Manufacturer's name
Model number HP Volts
Length of drop pipe ft. capacity g.p.m.
Type:
 Submersible Turbine
 Jet Reciprocating
 Centrifugal Other

18. Elevation: **3780**
Topography: **TPM**
 Hill
 Slope
 Upland
 Valley

19. Remarks: **windmill well**

20. Water well contractor's certification:
This well was drilled under my jurisdiction and this report is true to the best of my knowledge and belief.
Bartell Drilling **139**
Business name License No.
Address **winona, Kansas 67764**
Signed **Joyce Bartell** Date **10-7-78**
Authorized representative

T 13 41-0 31
R
E
S
E
N
W
S
E
1/4
1/4
1/4