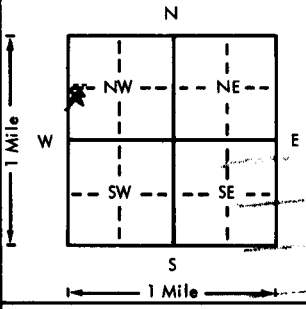


USE TYPEWRITER OR BALL POINT PEN-PRESS FIRMLY, PRINT CLEARLY.

BCB WATER WELL RECORD
KSA 82a-1201-1215

Kansas Department of Health and Environment-Division of Environment (Water well Contractors) Topeka, Kansas 66620

1. Location of well: County: <u>Wallace</u>		Fraction: <u>NW 1/4 SW 1/4 NW 1/4</u>		Section number: <u>2</u>		Township number: <u>T 13 S R 42 E/W</u>		Range number: <u>42</u>	
2. Distance and direction from nearest town or city: <u>5 1/2 miles North of Weskan, Kansas</u> Street address of well location if in city:					3. Owner of well: <u>Charles Raney</u> R.R. or street: City, state, zip code: <u>Weskan, Kansas</u>				
4. Locate with "X" in section below: Sketch map:  NW 1/4 SW 1/4 SW 1/4 Sec. 2 Twp 13 Rge 42					6. Bore hole dia. <u>30</u> in. Completion date <u>7-8-76</u> Well depth <u>267</u> ft.				
					7. <input type="checkbox"/> Cable tool <input type="checkbox"/> Rotary <input type="checkbox"/> Driven <input type="checkbox"/> Dug <input type="checkbox"/> Hollow rod <input type="checkbox"/> Jetted <input type="checkbox"/> Bored <input checked="" type="checkbox"/> Reverse rotary				
					8. Use: <input type="checkbox"/> Domestic <input type="checkbox"/> Public supply <input type="checkbox"/> Industry <input checked="" type="checkbox"/> Irrigation <input type="checkbox"/> Air conditioning <input type="checkbox"/> Stock <input type="checkbox"/> Lawn <input type="checkbox"/> Oil field water <input type="checkbox"/> Other				
					9. Casing: Material <u>steel</u> Height: Above or below Threaded <input type="checkbox"/> Welded <input checked="" type="checkbox"/> Surface <u>12</u> in. RMP <input type="checkbox"/> PVC <input type="checkbox"/> Weight <u>36</u> lbs./ft. Dia. <u>16</u> in. to <u>267</u> ft. depth; Wall Thickness: inches or Dia. <u> </u> in. to <u> </u> ft. depth; gage No. <u>.219</u>				
5. Type and color of material					From		To		
sand and sandy clay					0		103		
sand coarse sand					103		126		
coarse sandy clay					126		130		
coarse sand and gravel					130		141		
sandy clay					141		147		
clay and rock					147		153		
sand and gravel					153		159		
sandy clay					159		165		
good coarse sand					165		177		
sandy clay					177		183		
coarse sand					183		185		
sandy clay					185		192		
sandy clay and clay sandy clay and clay					192		217		
good coarse sand loose clean					217		243		
sandy clay					243		248		
medium to good sand					248		263		
shale (Use a second sheet if needed)					263		267		
18. Elevation:		19. Remarks: <u>BROCK 263'</u>							
Topography: <input type="checkbox"/> Hill <input checked="" type="checkbox"/> Slope <input type="checkbox"/> Upland <input type="checkbox"/> Valley		20. Water well contractor's certification: This well was drilled under my jurisdiction and this report is true to the best of my knowledge and belief. <u>Northwest Drilling Co., Inc. 24</u> Business name <u>Goodland Kansas</u> License No. <u> </u> Address <u>Ben Haney</u> Signed <u>Ben Haney</u> 11-9-76 Authorized representative							

T 13 R 42 E W 2 NW SW NW