

USE TYPEWRITER OR BALL POINT PEN-PRESS FIRMLY, PRINT CLEARLY.

WESKAN NW


WATER WELL RECORD  
KSA 82a-1201-1215

Kansas Department of Health and Environment-Division of Environment  
(Water well Contractors)  
Topeka, Kansas 66620

DDB

1. Location of well: County Wallace Fraction NW 1/4 SE 1/4 SE 1/4 Section number 21 Township number T 13 Range number S R 42 E 13

2. Distance and direction from nearest town or city: 2 N. Weskan 3. Owner of well: Orville Nickerson  
Street address of well location if in city: Ko. R.R. or street: Weskan Ko.  
City, state, zip code:

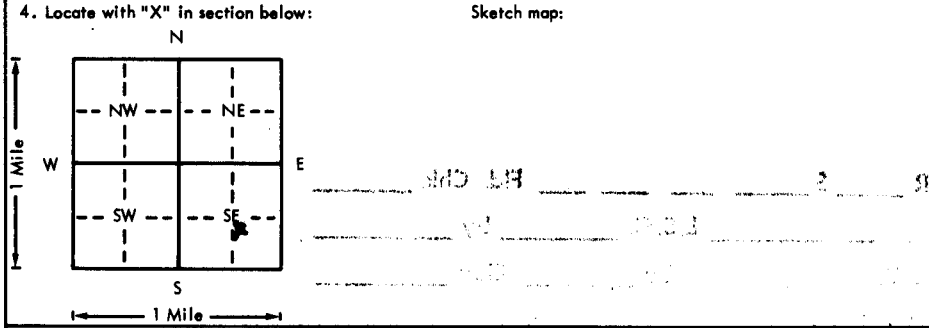

6. Bore hole dia. 28 in. Completion date 11-1-77  
Well depth 257 ft.

7. Cable tool  Rotary  Driven  Dug   
 Hollow rod  Jetted  Bored  Reverse rotary

8. Use:  Domestic  Public supply  Industry  Irrigation  Air conditioning  Stock  Lawn  Oil field water  Other

9. Casing: Steel Height: above or below  
Threaded  Welded  Surface 12 in.  
RMP 2 1/2 PVC Weight \_\_\_\_\_ lbs./ft.  
Dia. 16 in. to 257 ft. depth Wall Thickness: inches or  
Dia. \_\_\_\_\_ in. to \_\_\_\_\_ ft. depth gage No. 188

5. Type and color of material	From	To
<u>Top Soil</u>	<u>0</u>	<u>91</u>
<u>sand 7 to 11 clay streak</u>	<u>91</u>	<u>121</u>
<u>sand 7 to c + clay</u>	<u>121</u>	<u>136</u>
<u>sand + to c</u>	<u>136</u>	<u>139</u>
<u>Clay - tight</u>	<u>139</u>	<u>147</u>
<u>sand 7 to c</u>	<u>147</u>	<u>153</u>
<u>sand 7 to c clay - tight streak</u>	<u>153</u>	<u>162</u>
<u>sand 7 to c clay - little rock</u>	<u>162</u>	<u>178</u>
<u>Clay</u>	<u>178</u>	<u>182</u>
<u>sand 7 to c</u>	<u>182</u>	<u>202</u>
<u>Rock + clay</u>	<u>202</u>	<u>206</u>
<u>sand 7 to c</u>	<u>206</u>	<u>212</u>
<u>Clay + sand streak</u>	<u>212</u>	<u>218</u>
<u>sand 7 to c</u>	<u>218</u>	<u>248</u>
<u>Clay</u>	<u>248</u>	<u>252</u>
<u>sand 7 to c</u>	<u>252</u>	<u>257</u>
<u>Yellow</u> (Use a second sheet if needed)	<u>257</u>	<u>264</u>

10. Screen: Manufacturer's name W A Brown  
Type slotted Dia. 16  
Slot/gauge 3/32 Length 40  
Set between 217 ft. and 257 ft.  
Gravel pack?  Size range of material 1/4 x 3/8

11. Static water level: \_\_\_\_\_ mo./day/yr.  
92 ft. below land surface Date 11-1-77

12. Pumping level below land surfaces:  
109.6 ft. after 4 hrs. pumping 950 g.p.m.  
115 ft. after 4 hrs. pumping 1400 g.p.m.  
Estimated maximum yield 3000 g.p.m.

13. Water sample submitted: \_\_\_\_\_ mo./day/yr.  
Yes  No  Date \_\_\_\_\_

14. Well head completion:  
 Pitless adapter \_\_\_\_\_ Inches above grade

15. Well grouted?   
With:  Neat cement  Bentonite  Concrete  
Depth: From 0 ft. to 10 ft.

16. Nearest source of possible contamination:  
ft. \_\_\_\_\_ Direction \_\_\_\_\_ Type None  
Well disinfected upon completion?  Yes  No

17. Pump: Not installed  
Manufacturer's name \_\_\_\_\_  
Model number \_\_\_\_\_ HP \_\_\_\_\_ Volts \_\_\_\_\_  
Length of drop pipe \_\_\_\_\_ ft. capacity \_\_\_\_\_ g.p.m.  
Type:  
 Submersible  Turbine  
 Jet  Reciprocating  
 Centrifugal  Other

18. Elevation: \_\_\_\_\_ 19. Remarks: Blue shale  
BROOK 259  
3783 (TOPO)

Topography:  
 Hill  
 Slope  
 Upland  
 Valley

20. Water well contractor's certification:  
This well was drilled under my jurisdiction and this report is true to the best of my knowledge and belief.  
Blumley Drilling Co. Inc 214  
Business name License No.  
Address Box 503 Colby Ko  
Signed Manly Reel Date 12-1-77  
Authorized representative

T 13 R 42 E 13 NE SE SE