

USE TYPEWRITER OR BALL POINT PEN-PRESS FIRMLY, PRINT CLEARLY.

WESKAN NW


WATER WELL RECORD
KSA 82a-1201-1215

Kansas Department of Health and Environment-Division of Environment
(Water well Contractors)
Topeka, Kansas 66620

CDB

1. Location of well: County Wallace Fraction NW 1/4 SE 1/4 SW 1/4 Section number 22 Township number T 13 S Range number R 42 E (NW)

2. Distance and direction from nearest town or city: 2 N. Weston 3. Owner of well: Orville Nickerson
Street address of well location if in city: 800 Ko. R.R. or street: Weston Ko
City, state, zip code: Weston Ko

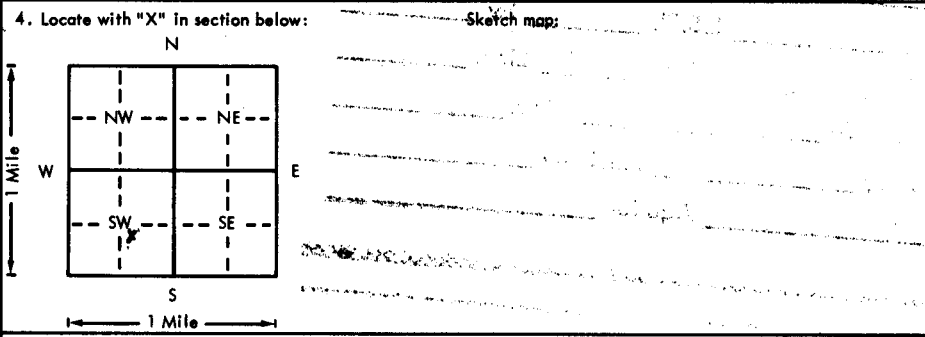

6. Bore hole dia. 2 1/2 in. Completion date 10-31-77
Well depth 242 ft.

7. Cable tool Rotary Driven Dug
 Hollow rod Jetted Bored Reverse rotary

8. Use: Domestic Public supply Industry
 Irrigation Air conditioning Stock
 Lawn Oil field water Other

9. Casing: Material Steel Height: above or below
Threaded Welded Surface 12 in.
RMP 3/4 in. PVC Weight _____ lbs./ft.
Dia. 1 1/2 in. to 2 1/2 ft. depth Wall Thickness: inches or
Dia. _____ in. to _____ ft. depth gauge No. 188

5. Type and color of material	From	To
<u>Top soil</u>	<u>0</u>	<u>31</u>
<u>clay + sand</u>	<u>31</u>	<u>61</u>
<u>sand + clay</u>	<u>61</u>	<u>70</u>
<u>sand fine to coarse</u>	<u>70</u>	<u>96</u>
<u>clay</u>	<u>96</u>	<u>105</u>
<u>sand f to c</u>	<u>105</u>	<u>112</u>
<u>sand + clay</u>	<u>112</u>	<u>118</u>
<u>sand f to c</u>	<u>118</u>	<u>121</u>
<u>Clay - sandy clay - sand</u>	<u>121</u>	<u>143</u>
<u>sand f to c</u>	<u>143</u>	<u>150</u>
<u>sand sandy clay + sand rock</u>	<u>150</u>	<u>162</u>
<u>sand f to c</u>	<u>162</u>	<u>174</u>
<u>Clay + sand rock</u>	<u>174</u>	<u>180</u>
<u>sand f to c</u>	<u>180</u>	<u>184</u>
<u>Clay</u>	<u>184</u>	<u>188</u>
<u>sand f to c</u>	<u>188</u>	<u>203</u>
<u>Clay</u> (Use a second sheet if needed)	<u>203</u>	<u>206</u>

10. Screen: Manufacturer's name WABrown
Type BUVER Dia. _____
Slot/gauze 2 1/2 Length 40
Set between 202 ft. and 242 ft.
_____ ft. and _____ ft.
Gravel pack? Size range of material 4/10

11. Static water level: _____ mo./day/yr.
58.4 ft. below land surface Date 10-31-77

12. Pumping level below land surfaces:
25.6 ft. after 4 hrs. pumping 800 g.p.m.
23.0 ft. after 4 hrs. pumping 1400 g.p.m.
Estimated maximum yield 3000 g.p.m.

13. Water sample submitted: _____ mo./day/yr.
Yes No Date _____

14. Well head completion:
 Pitless adapter _____ inches above grade

15. Well grouted?
With: Neat cement Bentonite Concrete
Depth: From 0 ft. to 10 ft.

16. Nearest source of possible contamination:
ft. _____ Direction _____ Type None
Well disinfected upon completion? Yes No

17. Pump: Not installed
Manufacturer's name _____
Model number _____ HP _____ Volts _____
Length of drop pipe _____ ft. capacity _____ g.p.m.
Type:
 Submersible Turbine
 Jet Reciprocating
 Centrifugal Other

18. Elevation:
Topography:
 Hill
 Slope
 Upland
 Valley

19. Remarks:
well #2 BROCK 250
3790 (TOPO)


20. Water well contractor's certification:
This well was drilled under my jurisdiction and this report is true to the best of my knowledge and belief.
Blue Jay Drilling Co. 214
Business name License No.
Address 21503 Colby Ko
Signed Manly Rail Date 11-31-77
Authorized representative

T 13 R 42 E S 22 NW SE SW 1/4 1/4 1/4

USE TYPEWRITER OR BALL POINT PEN-PRESS FIRMLY, PRINT CLEARLY.

WATER WELL RECORD
KSA 82a-1201-1215

Kansas Department of Health and Environment-Division of Environment (Water well Contractors) Topeka, Kansas 66620

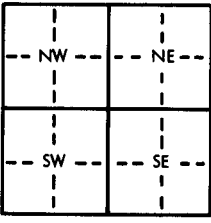1. Location of well: County <u>Wallace</u>		Fraction <u>NW</u> <u>1/4 SE 1/4 SW 1/4</u>		Section number <u>22</u>	Township number T <u>13</u> S R <u>42</u> E <u>(N)</u>	Range number
2. Distance and direction from nearest town or city: Street address of well location if in city:				3. Owner of well: <u>Orville Nickelson</u> R.R. or street: <u>Weston, KS</u> City, state, zip code:		
4. Locate with "X" in section below: N W E S 1 Mile Sketch map: 				6. Bore hole dia. _____ in. Completion date _____ Well depth _____ ft.		
				7. Cable tool _____ Rotary _____ Driven _____ Dug _____ Hollow rod _____ Jetted _____ Bored _____ Reverse rotary _____		
				8. Use: Domestic _____ Public supply _____ Industry _____ Irrigation _____ Air conditioning _____ Stock _____ Lawn _____ Oil field water _____ Other _____		
5. Type and color of material				9. Casing: Material _____ Height: Above or below _____ Threaded _____ Welded _____ Surface _____ in. RMP _____ PVC _____ Weight _____ lbs./ft. Dia. _____ in. to _____ ft. depth Wall Thickness: inches or _____ Dia. _____ in. to _____ ft. depth gage No. _____		
<u>Sand 7 to c</u>				From <u>206</u>	To <u>229</u>	10. Screen: Manufacturer's name _____
<u>clay + sand</u>				<u>229</u>	<u>236</u>	Type _____ Dia. _____ Slot/gauze _____ Length _____ Set between _____ ft. and _____ ft. _____ ft. and _____ ft.
<u>sand 7 to c</u>				<u>236</u>	<u>239</u>	Gravel pack? _____ Size range of material _____
<u>clay</u>				<u>239</u>	<u>241</u>	11. Static water level: _____ mo./day/yr. _____ ft. below land surface Date _____
<u>sand 7 to c + clay streak</u>				<u>241</u>	<u>250</u>	12. Pumping level below land surfaces: _____ ft. after _____ hrs. pumping _____ g.p.m. _____ ft. after _____ hrs. pumping _____ g.p.m. Estimated maximum yield _____ g.p.m.
<u>yellow + blue shale</u>				<u>250</u>	<u>256</u>	13. Water sample submitted: _____ mo./day/yr. Yes _____ No _____ Date _____
				14. Well head completion: _____ Pitless adapter _____ Inches above grade		
				15. Well grouted? _____ With: _____ Neat cement _____ Bentonite _____ Concrete _____ Depth: From _____ ft. to _____ ft.		
				16. Nearest source of possible contamination: ft. _____ Direction _____ Type _____ Well disinfected upon completion? _____ Yes _____ No		
				17. Pump: _____ Not installed Manufacturer's name _____ Model number _____ HP _____ Volts _____ Length of drop pipe _____ ft. capacity _____ g.p.m. Type: _____ Submersible _____ Turbine _____ Jet _____ Reciprocating _____ Centrifugal _____ Other		
(Use a second sheet if needed)						
18. Elevation: Topography: _____ Hill _____ Slope _____ Upland _____ Valley	19. Remarks:		20. Water well contractor's certification: This well was drilled under my jurisdiction and this report is true to the best of my knowledge and belief. <u>Blue Jay Paly</u> <u>214</u> Business name _____ License No. _____ Address <u>Box 503 Colby, KS</u> Signed _____ Date <u>11-31-72</u> Authorized representative			

T 13
R 42
S 22
E NW SE SW
1/4 1/4 1/4