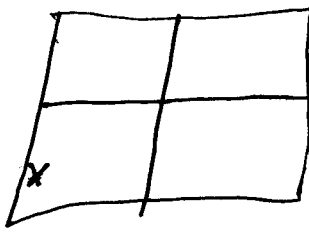


USE TYPEWRITER OR BALL POINT PEN-PRESS FIRMLY, PRINT CLEARLY.

WATER WELL RECORD  
KSA 82a-1201-1215

CCB *Weskan NW*

Kansas Department of Health and Environment-Division of Environment  
(Water well Contractors)  
Topeka, Kansas 66620

1. Location of well:	County: <i>S- Wallace</i>	Fraction: <i>NW 1/4 SW 1/4 SW 1/4</i>	Section number: <i>24</i>	Township number: <i>T 13</i>	Range number: <i>S R 42</i>	<i>E/W</i>
2. Distance and direction from nearest town or city:	<i>2 miles north of Weskan 1 east</i>		3. Owner of well:	<i>Leslie Walker</i>		
Street address of well location if in city:			R.R. or street:	<i>Weskan Kansas 67762</i>		
City, state, zip code:						
4. Locate with "X" in section below:	Sketch map:		6. Bore hole dia. <i>10</i> in. Completion date <i>11-4-77</i> Well depth <i>45</i> ft.			
N 1 Mile W E S 1 Mile			7. <input checked="" type="checkbox"/> Cable tool <input checked="" type="checkbox"/> Rotary <input type="checkbox"/> Driven <input type="checkbox"/> Dug <input type="checkbox"/> Hollow rod <input type="checkbox"/> Jetted <input type="checkbox"/> Bored <input type="checkbox"/> Reverse rotary			
5. Type and color of material			From	To	8. Use: <input checked="" type="checkbox"/> Domestic <input type="checkbox"/> Public supply <input type="checkbox"/> Industry <input type="checkbox"/> Irrigation <input type="checkbox"/> Air conditioning <input type="checkbox"/> Stock <input type="checkbox"/> Lawn <input type="checkbox"/> Oil field water <input type="checkbox"/> Other	
<i>Topsoil</i>			<i>0</i>	<i>1</i>	9. Casing: Material <i>STEEL</i> Height: <i>Above</i> or below Threaded <input checked="" type="checkbox"/> Welded <input type="checkbox"/> Surface <i>12</i> in. RMP <input type="checkbox"/> PVC <input type="checkbox"/> Weight <i>9</i> lbs./ft. Dia. <i>4 1/2</i> in. to <i>25</i> ft. depth Wall Thickness: inches or Dia. <input type="checkbox"/> in. to <input type="checkbox"/> ft. depth gage No. <i>188</i>	
<i>Clay &amp; Gravel</i>			<i>1</i>	<i>22</i>	10. Screen: Manufacturer's name <i>DORRER</i> Type <i>MILLSLOT</i> Dia. <i>4 1/2</i> Slot/gauze <i>1/2</i> Length <i>20'</i> Set between <i>25</i> ft. and <i>45</i> ft. ft. and <input type="checkbox"/> ft. Gravel pack? <input checked="" type="checkbox"/> Size range of material <i>24</i>	
<i>Gravel</i>			<i>22</i>	<i>30</i>	11. Static water level: <input type="checkbox"/> mo./day/yr. <i>16</i> ft. below land surface Date <i>11-4-77</i>	
<i>Clay</i>			<i>30</i>	<i>31</i>	12. Pumping level below land surfaces: <i>22</i> ft. after <i>4</i> hrs. pumping <input type="checkbox"/> g.p.m. <i>22</i> ft. after <i>4</i> hrs. pumping <i>10</i> g.p.m. Estimated maximum yield <i>10</i> g.p.m.	
<i>Gravel</i>			<i>31</i>	<i>34</i>	13. Water sample submitted: <input type="checkbox"/> mo./day/yr. Yes <input checked="" type="checkbox"/> No <input type="checkbox"/> Date	
<i>Soapstone</i>			<i>34</i>	<i>45</i>	14. Well head completion: <input checked="" type="checkbox"/> Pitless adapter <i>12</i> inches above grade	
<i>BROCK 34'</i>					15. Well grouted? <input checked="" type="checkbox"/> With: <input checked="" type="checkbox"/> Neat cement <input type="checkbox"/> Bentonite <input type="checkbox"/> Concrete Depth: From <i>12' below</i> to <i>10 ft. below</i>	
					16. Nearest source of possible contamination: ft. <input type="checkbox"/> Direction <input type="checkbox"/> Type <input type="checkbox"/> Well disinfected upon completion? <input checked="" type="checkbox"/> Yes <input type="checkbox"/> No	
					17. Pump: Not installed Manufacturer's name <i>Go4195</i> Model number <i>1005</i> HP <i>1</i> Volts <i>230</i> Length of drop pipe <i>36</i> ft. capacity <i>10</i> g.p.m. Type: <input checked="" type="checkbox"/> Submersible <input type="checkbox"/> Turbine <input type="checkbox"/> Jet <input type="checkbox"/> Reciprocating <input type="checkbox"/> Centrifugal <input type="checkbox"/> Other	
					20. Water well contractor's certification: This well was drilled under my jurisdiction and this report is true to the best of my knowledge and belief. <i>Foust Supply Co Inc</i> <i>144</i> Business name License No. Address <i>Box 338</i> Signed <i>Jeff Foust</i> Date <i>11-16-77</i> Authorized representative	
18. Elevation: <i>3680</i>			19. Remarks: <i>Concrete Run</i> <i>Foust Supply Co Inc.</i>			

77  
1342W  
24  
Sec  
1/4 1/4 1/4