

USE TYPEWRITER OR BALL POINT PEN-PRESS FIRMLY, PRINT CLEARLY.

T R EW sec 1/4 1/4 1/4 No.


WATER WELL RECORD  
KSA 82a-1201-1215

Kansas State Dept. Of Health  
(Water Well Contractors)  
Forbes-Bldg. 740  
Topeka, Kansas 66620

*BB D Wagon NW*

1 Location of well: County WALLACE Township name WESTMAN Section number 26 Town number 13 Range number 42 E

Distance and direction from nearest town or city: two miles North of Westman  
3 Owner of well: Gene Walker  
Street address of well location if in city: North of Westman Address: Westman Kans.

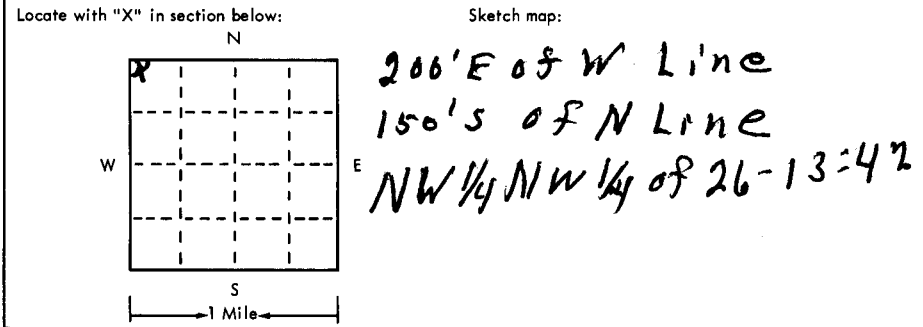

4 Well depth: 160 ft. Date of completion 5-30  
Well diameter 5 in.  
5  Cable tool  Rotary  Driven  Dug  
 Hollow rod  Jetted  Bored  Reverse rotary  
6 Use:  Domestic  Public supply  Industry  
 Irrigation  Air conditioning  Commercial  
 Test well   
7 Casing: Material PI Height: above/below  
Threaded  Welded  surface 2 1/2 ft.  
Diam. \_\_\_\_\_ Weight 250 lbs./ft. \_\_\_\_\_  
0 in. to 140 ft. depth Drive shoe?  Yes  No  
140 in. to 140 ft. depth!

2	Type and color of material	From	To
	Soil Ch. & Sand	0	31
	Sand & Ch. & Bark sticks	31	65
	Sand fine to coarse	65	95
	Clay	95	106
	Sand fine to coarse & little clay	106	158
	yellow & blue shale	158	160
	Red rock 158'		
	<i>7m</i>		

8 Screen: Manufacturer J & L  
Type Plastic Dia. 5"  
Slot/gauze Slot Length 70'  
Set between 140 ft. and 160 ft.  
Fittings: Gravel pack  Yes  No Size range of material 4  
9 Static water level: 60 ft. below land surface Date 5-21  
10 Pumping level below land surfaces:  
\_\_\_\_ ft. after \_\_\_\_ hrs. pumping \_\_\_\_ g.p.m.  
\_\_\_\_ ft. after \_\_\_\_ hrs. pumping \_\_\_\_ g.p.m.  
Estimated maximum yield \_\_\_\_ g.p.m.  
11 Water sample submitted:  
 Yes  No Date \_\_\_\_\_  
12 Well head completion:  
 Pitless adapter  Inches above grade 1'  
13 Well grouted?  Yes  No  
 Neat cement  Bentonite   
Depth: From 5 ft. to 15 ft.  
14 Nearest source of possible contamination: Stock  
ft. \_\_\_\_\_ Direction \_\_\_\_\_ Type well  
 Well disinfected upon completion?  Yes  No  
15 Pump:  Not installed  
Manufacturer's name \_\_\_\_\_  
Model number \_\_\_\_\_ HP \_\_\_\_\_ Volts \_\_\_\_\_  
Length of drop pipe \_\_\_\_\_ ft. capacity \_\_\_\_\_ g.m.p.  
Type:  Submersible  Turbine  
 Jet  Reciprocating  
 Centrifugal  Other Windmill

16 Remarks: elevation 3740 top  
Topography: 7m  
 Hill  
 Slope  
 Upland  
 Valley

17 Water well contractor's certification:  
This well was drilled under my jurisdiction and this report is true to the best of my knowledge and belief.  
Billy Husband 195  
Business name \_\_\_\_\_ License No. \_\_\_\_\_  
Address Westman Kans.  
Signed Billy Husband Date 6-10  
Authorized representative \_\_\_\_\_

13 42E 26 NW 1/4