

USE TYPEWRITER OR BALL POINT PEN—PRESS FIRMLY, PRINT CLEARLY.

T R EW sec 1/4 1/4 1/4 No.


WATER WELL RECORD  
KSA 82a-1201-1215

Kansas State Dept. Of Health  
(Water Well Contractors)  
Forbes-Bldg. 740  
Topeka, Kansas 66620

*Weskan*

1 Location of well: County Wallace Township name Weskan Section SE 1/4 Section number 33 Town number 13 Range number 42

Distance and direction from nearest town or city: one mile west 3 Owner of well: Martin Nusser  
Street address of well location if in city: OS Weskan, Kans Address: Garden City, Kans.

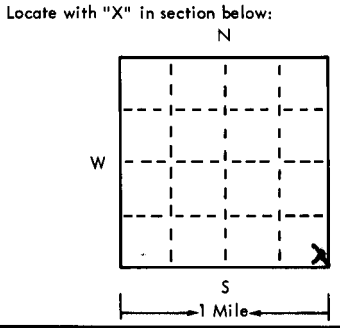

Sketch map:  
150' N of S Line  
75' W of E Line  
SE 1/4 SE 1/4 of 33-13-42

4 Well depth: 140' ft. Date of completion 6-15  
Well diameter 4" in.

5  Cable tool  Rotary  Driven  Dug  
 Hollow rod  Jetted  Bored  Reverse rotary

6 Use:  Domestic  Public supply  Industry  
 Irrigation  Air conditioning  Commercial  
 Test well

7 Casing: Material PL Height: above/below  
Threaded  Welded  Surface      in.  
Diam. 6 in. to 17 1/2 ft. depth Weight      lbs./ft.  
1 1/2 in. to 15 1/2 ft. depth Drive shoe?  Yes  No

2	Type and color of material	From	To
	Soil Cl & Sand	0	41
	Sand & Clay streak	41	91
	Sand & Cl	91	151
	Sand & Clay streak	151	163
	Clay & Sand streak	163	179
	Sand fine to coarse	179	186
	yellow & Blue Sand	186	191
	at brook 186		

8 Screen:  
Manufacturer       
Type Pearless Dia. 4"  
Slot/gauze Slot Length 20  
Set between 17 1/2 ft. and 19 1/2 ft.  
Fittings:  
Gravel pack  Yes  No Size range of material 1/4

9 Static water level:  
163 ft. below land surface Date 6-17

10 Pumping level below land surfaces:  
     ft. after      hrs. pumping      g.p.m.  
     ft. after      hrs. pumping      g.p.m.  
Estimated maximum yield 50 g.p.m.

11 Water sample submitted:  
 Yes  No Date     

12 Well head completion:  
 Pitless adapter  Inches above grade 1'

13 Well grouted?  Yes  No  
 Neat cement  Bentonite   
Depth: From 5 ft. to 15 ft.

14 Nearest source of possible contamination:  
ft. 200 Direction west Type Stream  
Well disinfected upon completion?  Yes  No

15 Pump:  Not installed  
Manufacturer's name Boyle  
Model number      HP 3/4 Volts 230  
Length of drop pipe 185 ft. capacity 12 g.m.p.  
Type:  
 Submersible  Turbine  
 Jet  Reciprocating  
 Centrifugal  Other

16 Remarks: elevation 3854 Topo       
Topography:       
 Hill  
 Slope  
 Upland  
 Valley

17 Water well contractor's certification:  
This well was drilled under my jurisdiction and this report is true to the best of my knowledge and belief.  
Billy Husband 195  
Business name      License No.       
Address 804 1/2 Weskan  
Signed Billy Husband Date 6-29  
Authorized representative

13 42W 33 SESE