

USE TYPEWRITER OR BALL POINT PEN-PRESS FIRMLY, PRINT CLEARLY.

WESKAN NW

T R EW sec 1/4 1/4 1/4 No.

WATER WELL RECORD
KSA 82a-1201-1215


Kansas State Dept. Of Health
(Water Well Contractors)
Forbes-Bldg. 740
Topeka, Kansas 66620

CAD

1 Location of well: County WALLACE Township name WESKAN E-N 1/4 SW 1/4 Section number 34 Town number 13 Range number 42

Distance and direction from nearest town or city: WESKAN
Street address of well location if in city: 1/2 N 1/2 W 1/4 N

3 Owner of well: MARVIN COX
Address: WESKAN KANSAS

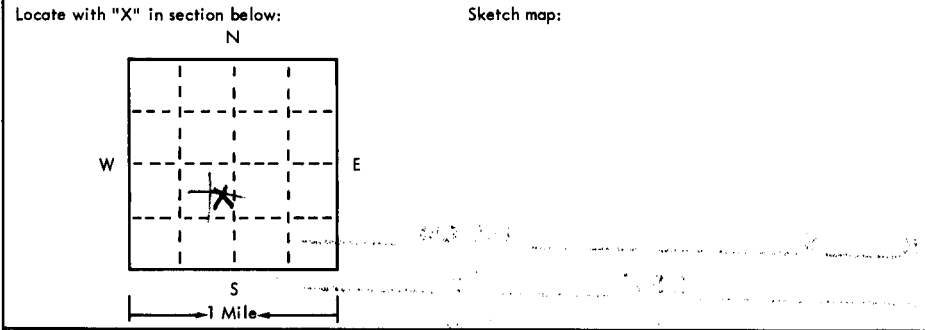

4 Well depth: 369 ft. Date of completion 2-19-75
Well diameter 2 1/2 in.

5 Cable tool Rotary Driven Dug
 Hollow rod Jetted Bored Reverse rotary

6 Use: Domestic Public supply Industry
 Irrigation Air conditioning Commercial
 Test well

7 Casing: Material Steel Height: above/below
Threaded Welded Surface 12 in.
Diam. 1 1/2 in. to 369 ft. depth Weight 33 lbs./ft. L
Drive shoe? Yes No
1 1/2 in. to ft. depth

2	Type and color of material	From	To
	<u>M GRAVEL, SANDY CLAY</u>	<u>145</u>	<u>176</u>
	<u>GRAVEL</u>	<u>176</u>	<u>188</u>
	<u>M GRAVEL, SANDY CLAY</u>	<u>188</u>	<u>223</u>
	<u>M GRAVEL, SANDY CLAY, SANDSTONE</u>	<u>223</u>	<u>265</u>
	<u>SANDY CLAY, SANDSTONE</u>	<u>265</u>	<u>270</u>
	<u>M GRAVEL</u>	<u>270</u>	<u>274</u>
	<u>M GRAVEL, SANDY CLAY, SANDSTONE</u>	<u>274</u>	<u>308</u>
	<u>M GRAVEL</u>	<u>308</u>	<u>325</u>
	<u>M GRAVEL, SANDSTONE</u>	<u>325</u>	<u>337</u>
	<u>M GRAVEL, SANDY CLAY</u>	<u>337</u>	<u>347</u>
	<u>SANDY CLAY</u>	<u>347</u>	<u>352</u>
	<u>M GRAVEL, TRACC CLAY</u>	<u>352</u>	<u>364</u>
	<u>SHALE</u>	<u>364</u>	<u>369</u>
	<u>BROCK 364'</u>		

8 Screen: Manufacturer W.A. BROWN
Type LIVER Dia. 1 1/2
Slot/gauze 1/8 - 7 Length 130
Set between 235 ft. and 365 ft.
Fittings: Gravel pack Yes No Size range of material 1/4 x 5/8

9 Static water level: 145 ft. below land surface Date 2-21-75

10 Pumping level below land surfaces:
170 ft. after 6 hrs. pumping 1250 g.p.m.
 ft. after hrs. pumping g.p.m.
Estimated maximum yield 2000 g.p.m.

11 Water sample submitted:
 Yes No Date

12 Well head completion:
 Pitless adapter Inches above grade

13 Well grouted? Yes No
 Neat cement Bentonite
Depth: From 0 ft. to 10 ft.

14 Nearest source of possible contamination:
ft. Direction Type NONE
Well disinfected upon completion? Yes No

15 Pump: Not installed
Manufacturer's name Westernland Roller
Model number 10M HP Volts
Length of drop pipe 300 ft. capacity 1800 g.p.m.
Type:
 Submersible Turbine
 Jet Reciprocating
 Centrifugal Other

16 Remarks: elevation 3662 (TOPO)

Topography:
 Hill
 Slope
 Upland
 Valley

17 Water well contractor's certification:
This well was drilled under my jurisdiction and this report is true to the best of my knowledge and belief.
A & H Drilling Co Inc 166
Business name Headland Kansas License No.
Address
Signed Paul Clifford Date 3-11-75
Authorized representative