


1 LOCATION OF WATER WELL: County: Wallace Fraction: SE 1/4 SE 1/4 SE 1/4 Section Number: 36 Township Number: T 13 S Range Number: R 42 EW

Distance and direction from nearest town or city street address of well if located within city?
2 mile east of Weskan

2 WATER WELL OWNER: Raymond Weas
 RR#, St. Address, Box #: Rt. 1 Box 41
 City, State, ZIP Code: Weskan KS 67762
 Board of Agriculture, Division of Water Resources
 Application Number:

3 LOCATE WELL'S LOCATION WITH AN "X" IN SECTION BOX:

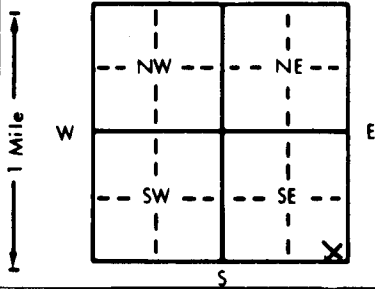

4 DEPTH OF COMPLETED WELL: 290 ft. ELEVATION:

Depth(s) Groundwater Encountered 1. ft. 2. ft. 3. ft.
 WELL'S STATIC WATER LEVEL ... 140 ft. below land surface measured on mo/day/yr ... 9-20-92
 Pump test data: Well water was ... 140 ft. after ... 1 hours pumping ... 30 gpm
 Est. Yield ... 50+ gpm; Well water was ... ft. after ... hours pumping ... gpm
 Bore Hole Diameter ... 8" in. to ... 290 ft., and ... in. to ... ft.
 WELL WATER TO BE USED AS:
 5 Public water supply 8 Air conditioning 11 Injection well
1 Domestic 3 Feedlot 6 Oil field water supply 9 Dewatering 12 Other (Specify below)
 2 Irrigation 4 Industrial 7 Lawn and garden only 10 Monitoring well
 Was a chemical/bacteriological sample submitted to Department? Yes.....No...X....; If yes, mo/day/yr sample was submitted
 Water Well Disinfected? Yes X No

5 TYPE OF BLANK CASING USED: 5 Wrought iron 8 Concrete tile CASING JOINTS: Glued X Clamped
 1 Steel 3 RMP (SR) 6 Asbestos-Cement 9 Other (specify below) Welded
2 PVC 4 ABS 7 Fiberglass Threaded

Blank casing diameter ... 5 in. to ... 270 ft., Dia ... in. to ... ft., Dia ... in. to ... ft.
 Casing height above land surface ... 24 in., weight ... 2.81 lbs./ft. Wall thickness or gauge No. ... 265

TYPE OF SCREEN OR PERFORATION MATERIAL:
 1 Steel 3 Stainless steel 5 Fiberglass 8 RMP (SR) 10 Asbestos-cement
 2 Brass 4 Galvanized steel 6 Concrete tile 9 ABS 11 Other (specify)
 12 None used (open hole)

SCREEN OR PERFORATION OPENINGS ARE:
 1 Continuous slot 3 Mill slot 5 Gauzed wrapped 8 Saw cut 11 None (open hole)
 2 Louvered shutter 4 Key punched 6 Wire wrapped 9 Drilled holes
 7 Torch cut 10 Other (specify)

SCREEN-PERFORATED INTERVALS: From ... 270 ft. to ... 290 ft., From ... ft. to ... ft.
 GRAVEL PACK INTERVALS: From ... ft. to ... ft., From ... ft. to ... ft.

6 GROUT MATERIAL: Neat cement 2 Cement grout 3 Bentonite 4 Other
 Grout intervals: From ... 5 ft. to ... 25 ft., From ... ft. to ... ft., From ... ft. to ... ft.

What is the nearest source of possible contamination:
 1 Septic tank 4 Lateral lines 7 Pit privy 10 Livestock pens 14 Abandoned water well
 2 Sewer lines 5 Cess pool 8 Sewage lagoon 11 Fuel storage 15 Oil well/Gas well
 3 Watertight sewer lines 6 Seepage pit 9 Feedyard 12 Fertilizer storage 16 Other (specify below)
 13 Insecticide storage
 Direction from well? S. E. How many feet? 30'

FROM	TO	LITHOLOGIC LOG	FROM	TO	PLUGGING INTERVALS
0	105	clay & sandy clay			
105	125	sandy clay strips			
135	150	sand			
150	288	sandy & sandy clay strips			
288	290	shale			

7 CONTRACTOR'S OR LANDOWNER'S CERTIFICATION: This water well was (1) constructed, (2) reconstructed, or (3) plugged under my jurisdiction and was completed on (mo/day/year) ... 9-20-92 and this record is true to the best of my knowledge and belief. Kansas Water Well Contractor's License No. ... 213 This Water Well Record was completed on (mo/day/yr) ... Sept. 28, 92 under the business name of Kemp's Well Service by (signature) George Kemp