


1 LOCATION OF WATER WELL: County: WALLACE Fraction: NW 1/4 NW 1/4 NE 1/4 Section Number: 36 Township Number: T 13 S Range Number: R 43 EW

Distance and direction from nearest town or city street address of well if located within city?

NW of WESKAN, KS

2 WATER WELL OWNER: ILEY SEXSON TRUST 1/2 DAVID SEXSON Board of Agriculture, Division of Water Resources  
 RR#, St. Address, Box #: 1415 RD 3 Application Number: 6,886  
 City, State, ZIP Code: WESKAN, KS, 67762

3 LOCATE WELL'S LOCATION WITH AN "X" IN SECTION BOX:

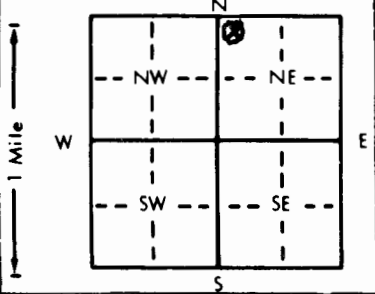

4 DEPTH OF COMPLETED WELL: 282 ft. ELEVATION: 3895  
 Depth(s) Groundwater Encountered 1. 210 ft. 2. \_\_\_\_\_ ft. 3. \_\_\_\_\_ ft.  
 WELL'S STATIC WATER LEVEL: 209 ft. below land surface measured on mo/day/yr 5-9-05  
 Pump test data: Well water was 246 ft. after 2 hours pumping 1100 gpm  
 Est. Yield 1100 gpm Well water was 225 ft. after 18 hours pumping 630 gpm  
 Bore Hole Diameter: 30 in. to 280.5 ft., and 17 in. to 282 ft.  
 WELL WATER TO BE USED AS:  
 5 Public water supply 8 Air conditioning 11 Injection well  
 1 Domestic 3 Feedlot 6 Oil field water supply 9 Dewatering 12 Other (Specify below)  
2 Irrigation 4 Industrial 7 Lawn and garden only 10 Monitoring well  
 Was a chemical/bacteriological sample submitted to Department? Yes No; If yes, mo/day/yr sample was submitted \_\_\_\_\_  
 Water Well Disinfected? Yes HTH No

5 TYPE OF BLANK CASING USED:  
 1 Steel 3 RMP (SR) 5 Wrought iron 8 Concrete tile CASING JOINTS: Glued \_\_\_\_\_ Clamped \_\_\_\_\_  
 2 PVC 4 ABS 6 Asbestos-Cement 9 Other (specify below) Welded  
 7 Fiberglass Threaded \_\_\_\_\_  
 Blank casing diameter: 16 in. to 232 ft., Dia. 16 in. to 282 ft., Dia. \_\_\_\_\_ in. to \_\_\_\_\_ ft.  
 Casing height above land surface: 12 in., weight 42.05 lbs./ft. Wall thickness or gauge No. 250  
 TYPE OF SCREEN OR PERFORATION MATERIAL:  
 1 Steel 3 Stainless steel 5 Fiberglass 7 PVC 10 Asbestos-cement  
 2 Brass 4 Galvanized steel 6 Concrete tile 8 RMP (SR) 11 Other (specify) \_\_\_\_\_  
 12 None used (open hole)  
 SCREEN OR PERFORATION OPENINGS ARE:  
 1 Continuous slot 3 Mill slot 5 Gauzed wrapped 8 Saw cut 11 None (open hole)  
 2 Louvered shutter 4 Key punched 6 Wire wrapped 9 Drilled holes JOHNSON AGRISCREEN  
 7 Torch cut 10 Other (specify) \_\_\_\_\_  
 SCREEN-PERFORATED INTERVALS: From 232 ft. to 272 ft., From \_\_\_\_\_ ft. to \_\_\_\_\_ ft.  
 From \_\_\_\_\_ ft. to \_\_\_\_\_ ft., From \_\_\_\_\_ ft. to \_\_\_\_\_ ft.  
 GRAVEL PACK INTERVALS: From 24 ft. to 282 ft., From \_\_\_\_\_ ft. to \_\_\_\_\_ ft.  
 From \_\_\_\_\_ ft. to \_\_\_\_\_ ft., From \_\_\_\_\_ ft. to \_\_\_\_\_ ft.

6 GROUT MATERIAL: 1 Neat cement 2 Cement grout 3 Bentonite 4 Other 6 SACK FIBERMESH  
 Grout Intervals: From +1 ft. to 24 ft., From \_\_\_\_\_ ft. to \_\_\_\_\_ ft., From \_\_\_\_\_ ft. to \_\_\_\_\_ ft.  
 What is the nearest source of possible contamination:  
 1 Septic tank 4 Lateral lines 7 Pit privy 10 Livestock pens 14 Abandoned water well  
 2 Sewer lines 5 Cess pool 8 Sewage lagoon 11 Fuel storage 15 Oil well/Gas well  
 3 Watertight sewer lines 6 Seepage pit 9 Feedyard 12 Fertilizer storage 16 Other (specify below) \_\_\_\_\_  
 13 Insecticide storage  
 Direction from well? WEST How many feet? 216'

FROM	TO	LITHOLOGIC LOG	FROM	TO	PLUGGING INTERVALS
0	13	TOP SOIL, SAND, GRAVEL			OLD WELL ABANDONMENT
13	22	BROWN CLAY, SANDY CLAY			
22	82	CLAY, SAND, GRAVEL, SANDSTONE			
82	156	SAND, GRAVEL, BR CLAY, SANDSTONE			
156	202	GRAVEL, SAND, SANDSTONE, CLAY			
202	212	SAND, GRAVEL	253	180	HTH + GRAVEL
212	220	SAND, GRAVEL, CLAY STREAKS	180	176	BENTONITE CHIPS
220	265	GRAVEL, SAND, CLAY STREAKS	176	8	NATIVE CLAYS
265	272	SAND, CLAY, BIG ROCKS, GRAVEL			CASING CUT OFF AT 8' + 1/4"
272	275	GREEN SHALE			STEEL PLATE WELDED SOLID TO CASING
275	282	BLACK SHALE			BENTONITE CHIPS PACK AROUND BORE HOLE + OLD CASING
			8	0	NATIVE CLAYS TO SURFACE

7 CONTRACTOR'S OR LANDOWNER'S CERTIFICATION: This water well was (1) constructed (2) reconstructed, or (3) plugged under my jurisdiction and was completed on (mo/day/year) 5-11-05 and this record is true to the best of my knowledge and belief. Kansas Water Well Contractor's License No. 633 This Water Well Record was completed on (mo/day/yr) 5-11-05 under the business name of DMW WELL + PUMP SERVICE by (signature) Jimmy T. Hutchell

OFFICE USE ONLY  
T  
R  
EW  
SEC  
1/4  
1/4  
1/4