


1 LOCATION OF WATER WELL: County: <b>SALINE</b>	Fraction <b>NW 1/4 NW 1/4 SW 1/4</b>	Section Number <b>14</b>	Township Number <b>T 13 S</b>	Range Number <b>R 5 EW</b>
--	---	-----------------------------	----------------------------------	-------------------------------

Distance and direction from nearest town or city street address of well if located within city?  
**4712 N. HOUSE RD. SALINE COUNTY PERMIT #99-209**

2 WATER WELL OWNER: **TERRY BURNETT**  
 RR#, St. Address, Box #: **4712 N. HOUSE RD.** Board of Agriculture, Division of Water Resources  
 City, State, ZIP Code: **BROOKVILLE, KS. 67425** Application Number:

3 LOCATE WELL'S LOCATION WITH AN "X" IN SECTION BOX:

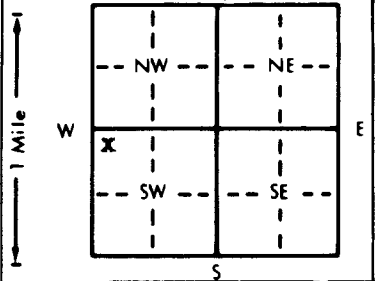

4 DEPTH OF COMPLETED WELL: **38.7** ft. ELEVATION:  
 Depth(s) Groundwater Encountered 1. **24** ft. 2. ft. 3. ft.  
 WELL'S STATIC WATER LEVEL: **24** ft. below land surface measured on mo/day/yr **6-30-99**  
 Pump test data: Well water was **28** ft. after **1** hours pumping **10** gpm  
 Est. Yield **10 to 12** gpm: Well water was ft. after hours pumping gpm  
 Bore Hole Diameter: **9** in. to **39** ft., and in. to ft.  
 WELL WATER TO BE USED AS:  
 1 Domestic 3 Feedlot 6 Oil field water supply 8 Air conditioning 11 Injection well  
 2 Irrigation 4 Industrial 7 Lawn and garden only 10 Dewatering 12 Other (Specify below)  
 Was a chemical/bacteriological sample submitted to Department? Yes No **X**; If yes, mo/day/yr sample was submitted  
 Water Well Disinfected? Yes **X** No

5 TYPE OF BLANK CASING USED:  
 1 Steel 3 RMP (SR) 5 Wrought iron 8 Concrete tile CASING JOINTS: Glued **X** Clamped  
 2 PVC 4 ABS 6 Asbestos-Cement 9 Other (specify below) Welded  
 7 Fiberglass Threaded  
 Blank casing diameter: **5** in. to **28.7** ft. Dia. in. to ft. Dia. in. to ft.  
 Casing height above land surface: **24** in., weight **160** lbs./ft. Wall thickness or gauge No. **SDR 26**

TYPE OF SCREEN OR PERFORATION MATERIAL:  
 1 Steel 3 Stainless steel 5 Fiberglass 8 RMP (SR) 10 Asbestos-cement  
 2 Brass 4 Galvanized steel 6 Concrete tile 9 ABS 11 Other (specify)  
 12 None used (open hole)

SCREEN OR PERFORATION OPENINGS ARE:  
 1 Continuous slot 3 Mill slot **.025** 5 Gauzed wrapped 8 Saw cut 11 None (open hole)  
 2 Louvered shutter 4 Key punched 6 Wire wrapped 9 Drilled holes  
 7 Torch cut 10 Other (specify)

SCREEN-PERFORATED INTERVALS: From **28.7** ft. to **38.7** ft. From ft. to ft.  
 From ft. to ft. From ft. to ft.  
 GRAVEL PACK INTERVALS: From **23** ft. to **38.7** ft. From ft. to ft.  
 From ft. to ft. From ft. to ft.

6 GROUT MATERIAL: 1 Neat cement 2 Cement grout 3 Bentonite 4 Other  
 Grout Intervals: From **3** ft. to **23** ft. From ft. to ft. From ft. to ft.

What is the nearest source of possible contamination:  
 1 Septic tank 4 Lateral lines 7 Pit privy 10 Livestock pens 14 Abandoned water well  
 2 Sewer lines 5 Cess pool 8 Sewage lagoon 11 Fuel storage 15 Oil well/Gas well  
 3 Watertight sewer lines 6 Seepage pit 9 Feedyard 12 Fertilizer storage 16 Other (specify below)  
 13 Insecticide storage **OPEN PASTURE NONE APPARENT**

Direction from well? How many feet?

FROM	TO	LITHOLOGIC LOG	FROM	TO	PLUGGING INTERVALS
0	1	TOP SOIL RED			
1	15	SANDSTONE RED SOFT			
15	18	CLAY LIGHT GRAY			
18	21	SANDSTONE RED SOFT			
21	35	SANDSTONE TAN SOFT			
35	49	CLAY GRAY			

7 CONTRACTOR'S OR LANDOWNER'S CERTIFICATION: This water well was (1) constructed, (2) reconstructed, or (3) plugged under my jurisdiction and was completed on (mo/day/year) **6-30-99** and this record is true to the best of my knowledge and belief. Kansas Water Well Contractor's License No. **388** This Water Well Record was completed on (mo/day/yr) **6-30-99** under the business name of **PESTINGER PUMP SERVICE** by (signature) *Paul P. Pester*

INSTRUCTIONS: Use typewriter or ball point pen. PLEASE PRESS FIRMLY and PRINT clearly. Please fill in blanks, underline or circle the correct answers. Send top three copies to Kansas Department of Health and Environment, Bureau of Water, Topeka, Kansas 66620-0001. Telephone: 913-296-5545. Send one to WATER WELL OWNER and retain one for your records.

OFFICE USE ONLY T R E SEC. 1/4 1/4 1/4