

WATER WELL RECORD

Form WWC-5

Division of Water Resources App. No.


Empty box for application number

1 LOCATION OF WATER WELL: County: Saline, Fraction 1/4 NW 1/4 NW 1/4 NW 1/4, Section Number 17, Township No. T 13 S, Range Number R 5

Street/Rural Address of Well Location; if unknown, distance & direction from nearest town or intersection: If at owner's address, check here [] 1W, 1N Glendale, KS

Global Positioning System (GPS) information: Latitude: (in decimal degrees), Longitude: (in decimal degrees), Elevation: Datum: [] WGS 84, [] NAD 83, [] NAD 27, Collection Method: [] GPS unit, [] Digital Map/Photo, [] Topographic Map, [] Land Survey, Est. Accuracy: [] <3 m, [] 3-5 m, [] 5-15 m, [] >15 m

2 WATER WELL OWNER: Bruce Springer, RR#, Street Address, Box #: 24 Willow Hill Road, City, State, ZIP Code: St. Louis, MO 63124

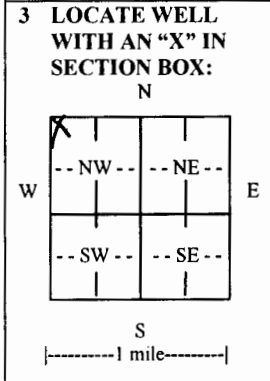

3 LOCATE WELL WITH AN "X" IN SECTION BOX: N, E, S, 4 DEPTH OF COMPLETED WELL 95, Depth(s) Groundwater Encountered (1) 60, WELL'S STATIC WATER LEVEL 60, Pump test data: Well water was... EST. YIELD 20, Bore Hole Diameter... WELL WATER TO BE USED AS: [] Public water supply, [] Geothermal, [] Injection well, [x] Domestic, [] Feedlot, [] Oil field water supply, [] Dewatering, [] Other, [] Irrigation, [] Industrial, [] Domestic-lawn & garden, [] Monitoring well, Was a chemical/bacteriological sample submitted to Department? [] Yes, [x] No, If yes, mo/day/yr sample was submitted, Water well disinfected? [x] Yes, [] No

5 TYPE OF CASING USED: [] Steel, [x] PVC, [] Other, CASING JOINTS: [x] Glued, [] Clamped, [] Welded, [] Threaded, Casing diameter .5 in. to .75 ft., Diameter in. to ft., Diameter in. to ft., Casing height above land surface .12 in., Weight 2.8 lbs./ft., Wall thickness or gauge No. Sch. 40, TYPE OF SCREEN OR PERFORATION MATERIAL: [] Steel, [] Stainless Steel, [x] PVC, [] Other, [] Brass, [] Galvanized Steel, [] None used, SCREEN OR PERFORATION OPENINGS ARE: [] Continuous slot, [] Mill slot, [] Gauze wrapped, [] Torch cut, [] Drilled holes, [] None, [] Louvered shutter, [] Key punched, [] Wire wrapped, [x] Saw cut, [] Other, SCREEN-PERFORATED INTERVALS: From .75 ft. to .95 ft., GRAVEL PACK INTERVALS: From .21 ft. to .95 ft.

6 GROUT MATERIAL: [] Neat cement, [] Cement grout, [x] Bentonite, [] Other, Grout Intervals: From 0 ft. to .21 ft., From ft. to ft., From ft. to ft., What is the nearest source of possible contamination: [] Septic tank, [] Lateral lines, [] Pit privy, [] Livestock pens, [] Insecticide storage, [] Other, [] Sewer lines, [] Cesspool, [] Sewage lagoon, [] Fuel storage, [] Abandoned water well, [] Watertight sewer lines, [] Seepage pit, [] Feedyard, [] Fertilizer storage, [] Oil well/gas well, none - in pasture, Direction from well, Distance from well

Table with columns: FROM, TO, LITHOLOGIC LOG, FROM, TO, LITHO. LOG (cont.) or PLUGGING INTERVALS. Rows: 0-2 top soil, 2-5 clay, 5-65 shale, 65-94 sand rock, 94-95 shale.

7 CONTRACTOR'S OR LANDOWNER'S CERTIFICATION: This water well was [x] constructed, [] reconstructed, or [] plugged under my jurisdiction and was completed on (mo/day/year) 06/06/12, Kansas Water Well Contractor's License No. 186, This Water Well Record was completed on (mo/day/year) 06/13/12, under the business name of Kelly's Water Well Service, Inc. by (signature) K. A. Thomas

INSTRUCTIONS: Use typewriter or ball point pen. PLEASE PRESS FIRMLY and PRINT clearly. Please fill in blanks and check the correct answers. Send three copies (white, blue, pink) to Kansas Department of Health and Environment, Bureau of Water, Geology Section, 1000 SW Jackson St., Suite 420, Topeka, Kansas 66612-1367. Telephone 785-296-5524. Send one copy to WATER WELL OWNER and retain one for your records. Include fee of \$5.00 for each constructed well. Visit us at http://www.kdheks.gov/waterwell/index.html.