


1 LOCATION OF WATER WELL: Fraction SW 1/4 SW 1/4 SE 1/4 Section Number 8 Township Number T 13 S Range Number R 6 (NW)

Distance and direction from nearest town or city street address of well if located within city?

Farmway Coop, Westfall Kansas

2 WATER WELL OWNER: Farmway Coop, Inc. RR# St. Address, Box #: P.O. Box 568 City, State, ZIP Code: Beloit, Kansas 67420 Board of Agriculture, Division of Water Resources Application Number:

3 LOCATE WELL'S LOCATION WITH AN "X" IN SECTION BOX:

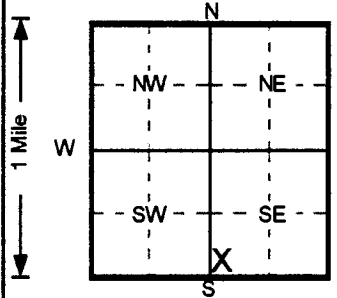

4 DEPTH OF COMPLETED WELL: 20 ft. ELEVATION: 1421.9. WELL'S STATIC WATER LEVEL: 11 ft. below land surface measured on 10/15/98. Pump test data: Well water was NA ft. after NA hours pumping. Est. Yield: NA gpm. Bore Hole Diameter: 8 in. to 20 ft. WELL WATER TO BE USED AS: 10 Monitoring well. Was a chemical/bacteriological sample submitted? No. Water Well Disinfected? Yes.

5 TYPE OF BLANK CASING USED: 2 PVC. Blank casing diameter: 2 in. to 8 ft. Dia. Casing height above land surface: -6.12 in. TYPE OF SCREEN OR PERFORATION MATERIAL: 7 PVC. SCREEN OR PERFORATION OPENINGS ARE: 3 Mill slot. SCREEN-PERFORATED INTERVALS: From 8 ft. to 18 ft. GRAVEL PACK INTERVALS: From 6 ft. to 20 ft.

6 GROUT MATERIAL: 2 Cement grout. Grout Intervals: From 0 ft. to 4 ft., From 4 ft. to 6 ft. What is the nearest source of possible contamination: 16 Other (specify below) Former Tank Basin. Direction from well? South. How many feet? 120

Table with 4 columns: FROM, TO, LITHOLOGIC LOG, PLUGGING INTERVALS. Rows include Clay, Brown (0-5), Clay, Red Brown (5-14), Shale, Gray Brown (14-18), and Shale, Red/Gray (18-20). Includes notes on MW14, Tag # 00273037, Flushmount and Project Name: Farmway Coop, Inc. - Westfall.

7 CONTRACTOR'S OR LANDOWNER'S CERTIFICATION: This water well was (1) constructed, (2) reconstructed, or (3) plugged under my jurisdiction and was completed on (mo/day/year) 9/24/98 and this record is true to the best of my knowledge and belief. Kansas Water Well Contractor's License No. 527. This Water Well Record was completed on (mo/day/yr) 10/15/98 under the business name of GeoCore Services, Inc. by (signature) Dave Col

OFFICE USE ONLY

T

R

EW

SEC

1/4

1/4

1/4