

1 LOCATION OF WATER WELL:	Fraction	Section Number	Township Number	Range Number
County: <b>Lincoln</b>	<b>NW 1/4 NW 1/4 NE 1/4</b>	<b>17</b>	<b>T 13 S</b>	<b>R 6 E/W</b>

Distance and direction from nearest town or city street address of well if located within city?

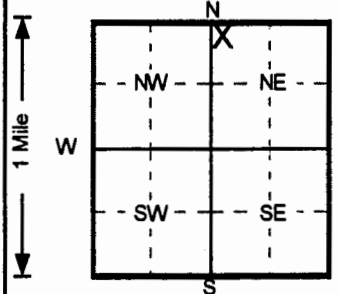
**East Main Streee, Westfall Kansas**2 WATER WELL OWNER: **Suelter Service**RR#, St. Address, Box # : **P.O. Box 502**

Board of Agriculture, Division of Water Resources

City, State, ZIP Code : **Westfall, Kansas 67455**

Application Number:

## 3 LOCATE WELL'S LOCATION WITH AN "X" IN SECTION BOX:

4 DEPTH OF COMPLETED WELL: **18** ft. ELEVATION: **1410.5**

Depth(s) Groundwater Encountered 1. .... ft. 2. .... ft. 3. .... ft.

WELL'S STATIC WATER LEVEL ... **7.62** ... ft. below land surface measured on mo/day/yr ... **10/15/98**Pump test data: Well water was ... **NA** ... ft. after ... hours pumping ... gpmEst. Yield ... **NA** ... gpm: Well water was ... ft. after ... hours pumping ... gpmBore Hole Diameter ... **8** ... in. to ... **18** ... ft., and ... in. to ... ft.

WELL WATER TO BE USED AS: 5 Public water supply 8 Air conditioning 11 Injection well

1 Domestic 3 Feedlot 6 Oil field water supply 9 Dewatering 12 Other (Specify below)

2 Irrigation 4 Industrial 7 Lawn and garden only **10** Monitoring well

Was a chemical/bacteriological sample submitted to Department? Yes.....No.....; If yes, mo/day/yr sample was submitted

Water Well Disinfected? Yes No ☒

## 5 TYPE OF BLANK CASING USED:

1 Steel 3 RMP (SR) 5 Wrought iron 8 Concrete tile CASING JOINTS: Glued ..... Clamped .....

**2** PVC 4 ABS 6 Asbestos-Cement 9 Other (specify below) Welded .....Blank casing diameter ... **2** ... in. to ... **8** ... ft., Dia ... in. to ... ft., Dia ... in. to ... ft.Casing height above land surface ... **23.52** ... in., weight ... **Sch 40** ... lbs./ft. Wall thickness or gauge No. ....

## TYPE OF SCREEN OR PERFORATION MATERIAL

1 Steel 3 Stainless steel 5 Fiberglass 8 RMP (SR) 10 Asbestos-cement

2 Brass 4 Galvanized steel 6 Concrete tile 9 ABS 11 Other (specify) .....

SCREEN OR PERFORATION OPENINGS ARE: 5 Gauzed wrapped 8 Saw cut 11 None (open hole)

1 Continuous slot **3** Mill slot 6 Wire wrapped 9 Drilled holes

2 Louvered shutter 4 Key punched 7 Torch cut 10 Other (specify) .....

SCREEN-PERFORATED INTERVALS: From ... **8** ... ft. to ... **18** ... ft., From ... ft. to ... ft.

From ... ft. to ... ft., From ... ft. to ... ft.

GRAVEL PACK INTERVALS: From ... **7** ... ft. to ... **18** ... ft., From ... ft. to ... ft.

From ... ft. to ... ft., From ... ft. to ... ft.

6 GROUT MATERIAL: 1 Neat cement **2** Cement grout **3** Bentonite 4 Other .....Grout Intervals: From ... **0** ... ft. to ... **3** ... ft., From ... **3** ... ft. to ... **7** ... ft., From ... ft. to ... ft.

What is the nearest source of possible contamination:

1 Septic tank 4 Lateral lines 7 Pit privy 10 Livestock pens 14 Abandoned water well

2 Sewer lines 5 Cess pool 8 Sewage lagoon 11 Fuel storage 15 Oil well/Gas well

3 Watertight sewer lines 6 Seepage pit 9 Feedyard 12 Fertilizer storage **16** Other (specify below)Direction from well? **Northwest** 13 Insecticide storage **Former Tank Basin...**How many feet? **360**

FROM TO LITHOLOGIC LOG FROM TO PLUGGING INTERVALS

0 4 Clay, Dark Brown

4 9 Clay, Red Brown

9 18 Sand, Red Brown

7 CONTRACTOR'S OR LANDOWNER'S CERTIFICATION: This water well was **(1)** constructed, (2) reconstructed, or (3) plugged under my jurisdictionand was completed on (mo/day/year) ... **9/22/98** ... and this record is true to the best of my knowledge and belief.Kansas Water Well Contractor's License No. ... **527** ... This Water Well Record was completed on (mo/day/yr) ... **10/15/98** ...under the business name of **GeoCore Services, Inc.** by (signature) *John Roff*

OFFICE USE ONLY

T

R

EW

SEC.

%

%

%