

**WATER WELL PLUGGING RECORD Form WWC-5P**

KSA 82a-1212

ID NO.

MW28

**1 LOCATION OF WATER WELL:** Fraction SE ¼ SE ¼ SE ¼ SW ¼ Section Number 8 Township Number 13 T S Range Number 6  E  W  
 County: Lincoln


Street/Rural Address of Well Location; if unknown, distance & direction from nearest town or intersection: If at owner's address, check here  East Main St., Westfall, KS

**Global Positioning Systems (GPS) information:**  
 Latitude: 38.92969 (in decimal degrees)  
 Longitude: -98.01243 (in decimal degrees)  
 Elevation: 1425.91  
 Horizontal Datum:  WGS84,  NAD83,  NAD27  
 Collection Method:

**2 WATER WELL OWNER:** Suelter Service  
 RR#, St. Address, Box #: PO Box 502  
 City, State ZIP Code: Westfall, KS 67455

GPS unit (Make/Model: \_\_\_\_\_)  
 Digital Map/Photo,  Topographic Map,  Land Survey  
 Est. Accuracy:  < 3 m,  3-5 m,  5-15 m,  > 15 m

**3 MARK WELL'S LOCATION WITH AN "X" IN SECTION BOX:**

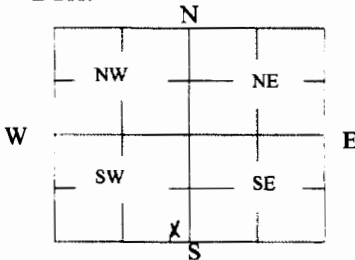

**4 DEPTH OF WELL** 22.76 ft.

WELL'S STATIC WATER LEVEL 19.36 ft

WELL WAS USED AS:

- Domestic
- Public Water Supply
- Dewatering
- Irrigation
- Oil Field Water Supply
- Monitoring
- Feedlot
- Domestic (Lawn & Garden)
- Injection Well
- Industrial
- Air Conditioning
- Other

Was a chemical/bacteriological sample submitted to Department? Yes  No

**5 TYPE OF BLANK CASING USED:**

- Steel
- RMP (SR)
- Wrought
- Fiberglass
- Other (Specify below)
- PVC
- ABS
- Asbestos-Cement
- Concrete Tile

Blank casing diameter 2 in. Was casing pulled? Yes  No  If yes, how much 3'  
 Casing height above or below land surface +31.68 in.

**6 GROUT PLUG MATERIAL:**  Neat cement  Cement grout  Bentonite  Other Native Soil

Grout Plug Intervals: From 3 ft. to 22.76 ft., From 0 ft. to 3 ft., From \_\_\_\_\_ ft. to \_\_\_\_\_ ft.

What is the nearest source of possible contamination:

- Septic tank
  - Seepage pit
  - Fuel storage
  - Other (specify below)
  - Sewer lines
  - Pit privy
  - Fertilizer storage
  - Watertight sewer lines
  - Sewage lagoon
  - Insecticide storage
  - Lateral lines
  - Feedyard
  - Abandoned water well
  - Oil well/Gas well
  - Cess pool
  - Livestock pens
- Direction from well? \_\_\_\_\_  
 How many feet? \_\_\_\_\_

FROM	TO	PLUGGING MATERIALS	FROM	TO	PLUGGING MATERIALS
0	3	Native Soil			
3	22.76	Bentonite			

**7 CONTRACTOR'S OR LANDOWNER'S CERTIFICATION:** This water well was plugged under my jurisdiction and was completed on (mo/day/year) 12/28/2022 and this record is true to the best of my knowledge and belief. Kansas Water Well Contractor's License No. 527 This Water Well Record was completed on (mo/day/year) 12/29/2022 under the business name of GeoCore LLC by (signature) [Signature]

Send one white copy to Kansas Department of Health & Environment, Geology Section, 1000 SW Jackson Street, Ste. 420, Topeka, KS 66612-1367. Send one copy to WATER WELL OWNER and retain one for your records.  
 Visit us at <http://www.kdheks.gov/waterwell/index.html> Telephone 785-296-5524.