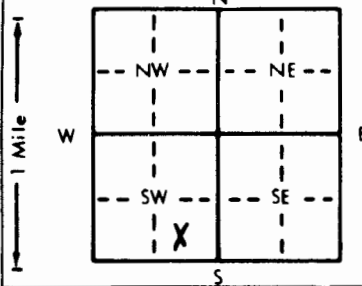


1 LOCATION OF WATER WELL: Fraction SW 1/4 SE 1/4 SW 1/4 Section Number 10 Township Number T 13 S Range Number R 7 EW  
 County: Lincoln

Distance and direction from nearest town or city street address of well if located within city?  
4 miles West of Schoolhouse, Westfalls, KS

2 WATER WELL OWNER: Alfred Aufderberg  
 RR#, St. Address, Box #: Rt 2, Box 62  
 City, State, ZIP Code: Lincoln, KS 67455  
 Board of Agriculture, Division of Water Resources  
 Application Number:

3 LOCATE WELL'S LOCATION WITH AN "X" IN SECTION BOX:  


4 DEPTH OF COMPLETED WELL: 120 ft. ELEVATION: 999  
 Depth(s) Groundwater Encountered: 1 ft. 2. . . . . ft. 3. . . . . ft.  
 WELL'S STATIC WATER LEVEL: 55 ft. below land surface measured on mo/day/yr  
 Pump test data: Well water was . . . . . ft. after . . . . . hours pumping . . . . . gpm  
 Est. Yield . . . . . gpm: Well water was . . . . . ft. after . . . . . hours pumping . . . . . gpm  
 Bore Hole Diameter: 10 in. to 120 ft., and . . . . . in. to . . . . . ft.  
 WELL WATER TO BE USED AS:  
 Domestic 3 Feedlot 6 Oil field water supply 9 Dewatering 12 Other (Specify below)  
 2 Irrigation 4 Industrial 7 Lawn and garden only 10 Monitoring well  
 Was a chemical/bacteriological sample submitted to Department? Yes . . . . . No ; If yes, mo/day/yr sample was submitted  
 Water Well Disinfected? Yes . . . . . No

5 TYPE OF BLANK CASING USED:  
 1 Steel 3 RMP (SR) 5 Wrought iron 8 Concrete tile CASING JOINTS: Glued . . . . . Clamped . . . . .  
 PVC 4 ABS 6 Asbestos-Cement 9 Other (specify below) Welded . . . . .  
 7 Fiberglass Threaded . . . . .  
 Blank casing diameter: 5 in. to 80 ft., Dia . . . . . in. to . . . . . ft., Dia . . . . . in. to . . . . . ft.  
 Casing height above land surface: 15 in., weight Sch 40 lbs./ft. Wall thickness or gauge No. . . . .  
 TYPE OF SCREEN OR PERFORATION MATERIAL:  
 PVC 10 Asbestos-cement  
 1 Steel 3 Stainless steel 5 Fiberglass 8 RMP (SR) 11 Other (specify) . . . . .  
 2 Brass 4 Galvanized steel 6 Concrete tile 9 ABS 12 None used (open hole)  
 SCREEN OR PERFORATION OPENINGS ARE:  
 1 Continuous slot  Mill slot 5 Gauzed wrapped 8 Saw cut 11 None (open hole)  
 2 Louvered shutter 4 Key punched 6 Wire wrapped 9 Drilled holes  
 7 Torch cut 10 Other (specify) . . . . .  
 SCREEN-PERFORATED INTERVALS: From: 80 ft. to 110 ft., From . . . . . ft. to . . . . . ft.  
 From: . . . . . ft. to . . . . . ft., From . . . . . ft. to . . . . . ft.  
 GRAVEL PACK INTERVALS: From: 50 ft. to 120 ft., From . . . . . ft. to . . . . . ft.  
 From . . . . . ft. to . . . . . ft., From . . . . . ft. to . . . . . ft.

6 GROUT MATERIAL: 1 Neat cement 2 Cement grout  Bentonite 4 Other . . . . .  
 Grout intervals: From: 0 ft. to 50 ft., From . . . . . ft. to . . . . . ft., From . . . . . ft. to . . . . . ft.  
 What is the nearest source of possible contamination:  
 1 Septic tank 4 Lateral lines 7 Pit privy 10 Livestock pens 14 Abandoned water well  
 2 Sewer lines 5 Cess pool 8 Sewage lagoon 11 Fuel storage 15 Oil well/Gas well  
 3 Watertight sewer lines 6 Seepage pit 9 Feedyard 12 Fertilizer storage  Other (specify below)  
Unknown  
 13 Insecticide storage  
 Direction from well? How many feet?

| FROM | TO  | LITHOLOGIC LOG            | FROM | TO | PLUGGING INTERVALS |
|------|-----|---------------------------|------|----|--------------------|
| 0    | 1   | Topsoil                   |      |    |                    |
| 1    | 4   | Shale, Red-Light Gray     |      |    |                    |
| 4    | 15  | Shale, Light Gray/Red     |      |    |                    |
| 15   | 18  | Shale, DK Gray            |      |    |                    |
| 18   | 19  | Shale, Gray/Ironstone     |      |    |                    |
| 19   | 22  | Shale, Lt Gray/Orng + Red |      |    |                    |
| 22   | 55  | Shale, Lt Gray/trace Red  |      |    |                    |
| 55   | 80  | Shale, med. Gray          |      |    |                    |
| 80   | 88  | Shale, med to DK Gray     |      |    |                    |
| 88   | 110 | Shale, med to Lt Gray     |      |    |                    |
| 110  | 120 | Shale, med Gray           |      |    |                    |

7 CONTRACTOR'S OR LANDOWNER'S CERTIFICATION: This water well was  (1) constructed, (2) reconstructed, or (3) plugged under my jurisdiction and was completed on (mo/day/year) 6-19-98 and this record is true to the best of my knowledge and belief. Kansas Water Well Contractor's License No. 521 This Water Well Record was completed on (mo/day/yr) 7-14-98 under the business name of GeoCore Services, Inc. by (signature) Joe Kohl

INSTRUCTIONS: Use typewriter or ball point pen. PLEASE PRESS FIRMLY and PRINT clearly. Please fill in blanks, underline or circle the correct answers. Send top three copies to Kansas Department of Health and Environment, Bureau of Water, Topeka, Kansas 66620-0001. Telephone: 913-296-5545. Send one to WATER WELL OWNER and retain one for your records.

OFFICE USE ONLY  
T  
R  
EW  
SEC.