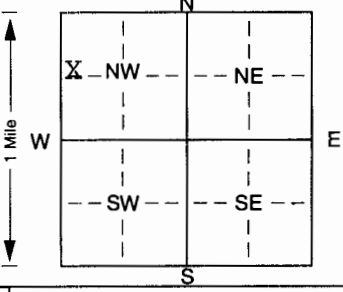


KSA 82a-1212 ID No.

1 LOCATION OF WATER WELL: County: Lincoln		Fraction SW 1/4 NW 1/4 NW 1/4		Section Number 28		Township Number T 13 S		Range Number R 8W EW	
Distance and direction from nearest town or city street address of well if located within city? 9 1/4S, 3E of Vesper, Ks.									
2 WATER WELL OWNER: Rosemary Rathburn RR#, St. Address, Box #: 263 N. 150th Road City, State, ZIP Code: Lincoln, Ks. 67455 Board of Agriculture, Division of Water Resources Application Number:									
3 LOCATE WELL'S LOCATION WITH AN "X" IN SECTION BOX: 			4 DEPTH OF COMPLETED WELL: 108 ft. ELEVATION: unknown Depth(s) Groundwater Encountered 1. 34 ft. 2. ft. 3. ft. WELL'S STATIC WATER LEVEL 34 ft. below land surface measured on mo/day/yr 08/06/02 Pump test data: Well water was ft. after hours pumping gpm Est. Yield 10 gpm: Well water was ft. after hours pumping gpm Bore Hole Diameter 8 in. to 108 ft., and in. to ft. WELL WATER TO BE USED AS: 5 Public water supply 8 Air conditioning 11 Injection well 1 Domestic 3 Feedlot 6 Oil field water supply 9 Dewatering 12 Other (Specify below) 2 Irrigation 4 Industrial 7 Domestic (lawn & garden) 10 Monitoring well Was a chemical/bacteriological sample submitted to Department? Yes. No.; If yes, mo/day/yr sample was submitted Water Well Disinfected? Yes No						
5 TYPE OF BLANK CASING USED: 1 Steel 3 RMP (SR) 5 Wrought iron 8 Concrete tile CASING JOINTS: Glued. Clamped. 2 PVC 4 ABS 6 Asbestos-Cement 9 Other (specify below) Welded Blank casing diameter 5 in. to 28 ft., Dia in. to ft., Dia in. to ft. Casing height above land surface 12 in., weight 2.8 lbs./ft. Wall thickness or gauge No. Sch. 40 TYPE OF SCREEN OR PERFORATION MATERIAL: 1 Steel 3 Stainless steel 5 Fiberglass 7 PVC 10 Asbestos-cement 2 Brass 4 Galvanized steel 6 Concrete tile 8 RMP (SR) 11 Other (specify) SCREEN OR PERFORATION OPENINGS ARE: 1 Continuous slot 3 Mill slot 5 Gauzed wrapped 8 Saw cut 11 None (open hole) 2 Louvered shutter 4 Key punched 7 Torch cut 9 Drilled holes SCREEN-PERFORATED INTERVALS: From 28 ft. to 68 ft., From 88 ft. to 108 ft. GRAVEL PACK INTERVALS: From 23 ft. to 108 ft., From ft. to ft. 6 GROUT MATERIAL: 1 Neat cement 2 Cement grout 3 Bentonite 4 Other Grout Intervals: From 0 ft. to 23 ft., From ft. to ft., From ft. to ft. What is the nearest source of possible contamination: 1 Septic tank 4 Lateral lines 7 Pit privy 10 Livestock pens 14 Abandoned water well 2 Sewer lines 5 Cess pool 8 Sewage lagoon 11 Fuel storage 15 Oil well/Gas well 3 Watertight sewer lines 6 Seepage pit 9 Feedyard 12 Fertilizer storage 16 Other (specify below) Direction from well? East How many feet? 50									
FROM TO LITHOLOGIC LOG FROM TO PLUGGING INTERVALS 0 3 top soil 3 25 clay 25 62 sand rock streaks 62 80 shale 80 108 sand rock streaks									
7 CONTRACTOR'S OR LANDOWNER'S CERTIFICATION: This water well was (1) constructed, (2) reconstructed, or (3) plugged under my jurisdiction and was completed on (mo/day/year) 08/06/02 and this record is true to the best of my knowledge and belief. Kansas Water Well Contractor's Licence No. 186 This Water Well Record was completed on (mo/day/yr) 08/07/02 under the business name of Kelly's Water Well Service, Inc. by (signature) Kathy L. Ward									
INSTRUCTIONS: Use typewriter or ball point pen. PLEASE PRESS FIRMLY and PRINT clearly. Please fill in blanks, underline or circle the correct answers. Send top three copies to Kansas Department of Health and Environment, Bureau of Water, Topeka, Kansas 66620-0001. Telephone 785-296-5524. Send one to WATER WELL OWNER and retain one for your records. Fee of \$5.00 for each constructed well.									