

WATER WELL RECORD


Form WWC-5

Division of Water Resources App. No.

1 LOCATION OF WATER WELL: County: SALINE Fraction NE 1/4 SW 1/4 SW 1/4 SW 1/4 Section Number 9 Township No. T 14 S Range Number R 1 E 2W

Street/Rural Address of Well Location: 208 N. KIPP ROAD Global Positioning System (GPS) information: Latitude: Longitude: Elevation: Datum: Collection Method: GPS unit Digital Map/Photo Topographic Map Land Survey Est. Accuracy: <3 m 3-5 m 5-15 m >15 m

2 WATER WELL OWNER: JERRY SEIM RR#, Street Address, Box #: 208 N. KIPP RD City, State, ZIP Code: SALINA, KS 67401

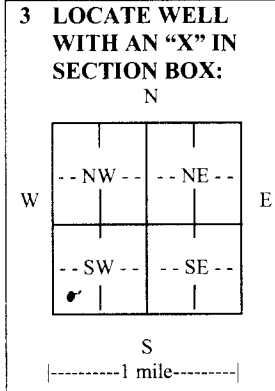

4 DEPTH OF COMPLETED WELL 90 ft. Depth(s) Groundwater Encountered (1) 60 ft. (2) ft. (3) ft. WELL'S STATIC WATER LEVEL 48 ft. below land surface measured on mo/day/yr 0 Pump test data: Well water was 80 ft. after 1/4 hours pumping 20 gpm EST. YIELD 7.00 gpm. Well water was ft. after hours pumping gpm Bore Hole Diameter 9 in. to 90 ft. and in. to ft. WELL WATER TO BE USED AS: [X] Domestic [ ] Feedlot [ ] Oil field water supply [ ] Geothermal [ ] Injection well [ ] Irrigation [ ] Industrial [ ] Domestic-lawn & garden [ ] Dewatering [ ] Other (Specify below) [ ] Monitoring well Was a chemical/bacteriological sample submitted to Department? [ ] Yes [X] No If yes, mo/day/yr sample was submitted. Water well disinfected? [X] Yes [ ] No

5 TYPE OF CASING USED: [ ] Steel [X] PVC [ ] Other CASING JOINTS: [X] Glued [ ] Clamped [ ] Welded [ ] Threaded Casing diameter 5 in. to 10 ft., Diameter in. to ft., Diameter in. to ft. Casing height above land surface 24 in., Weight 160 lbs./ft., Wall thickness or gauge No. SDE 26

TYPE OF SCREEN OR PERFORATION MATERIAL: [ ] Steel [ ] Stainless Steel [X] PVC [ ] Other (Specify) [ ] Brass [ ] Galvanized Steel [ ] None used (open hole) SCREEN OR PERFORATION OPENINGS ARE: [ ] Continuous slot [X] Mill slot .025 [ ] Gauze wrapped [ ] Torch cut [ ] Drilled holes [ ] None (open hole) [ ] Louvered shutter [ ] Key punched [ ] Wire wrapped [ ] Saw cut [ ] Other (specify) SCREEN-PERFORATED INTERVALS: From 80 ft. to 90 ft., From ft. to ft., From ft. to ft. GRAVEL PACK INTERVALS: From NA ft. to ft., From ft. to ft., From ft. to ft. From ft. to ft., From ft. to ft.

6 GROUT MATERIAL: [ ] Neat cement [ ] Cement grout [ ] Bentonite [ ] Other Grout intervals: From 0 ft. to 25 ft., From 50 ft. to 60 ft., From ft. to ft. What is the nearest source of possible contamination: [X] Septic tank [ ] Lateral lines [ ] Pit privy [ ] Livestock pens [ ] Insecticide storage [ ] Other (specify below) [ ] Sewer lines [ ] Cesspool [ ] Sewage lagoon [ ] Fuel storage [ ] Abandoned water well [ ] Watertight sewer lines [ ] Seepage pit [ ] Feedyard [ ] Fertilizer storage [ ] Oil well/gas well Direction from well SOUTH Distance from well 100

Table with columns: FROM, TO, LITHOLOGIC LOG, FROM, TO, LITHO. LOG (cont.) or PLUGGING INTERVALS. Rows include: 0-2 TOP SOIL BROWN, 2-44 CLAY TAN TO BROWN SILTY, 44-58 CLAY LIGHT GRAY, 58-90 SHALE DARK GRAY FRACTURED, SHALE BOOT SET AT 60'

7 CONTRACTOR'S OR LANDOWNER'S CERTIFICATION: This water well was [X] constructed, [ ] reconstructed, or [ ] plugged under my jurisdiction and was completed on (mo/day/year) 07-06-12 and this record is true to the best of my knowledge and belief. Kansas Water Well Contractor's License No. 388 This Water Well Record was completed on (mo/day/year) 07-06-12 under the business name of PESTINGEE PUMP SERVICE by (signature) Jeff Weathers

INSTRUCTIONS: Use typewriter or ball point pen. PLEASE PRESS FIRMLY and PRINT clearly. Please fill in blanks and check the correct answers. Send three copies (white, blue, pink) to Kansas Department of Health and Environment, Bureau of Water, Geology Section, 1000 SW Jackson St., Suite 420, Topeka, Kansas 66612-1367. Telephone 785-296-5524. Send one copy to WATER WELL OWNER and retain one for your records. Include fee of \$5.00 for each constructed well. Visit us at http://www.kdheks.gov/waterwell/index.html.