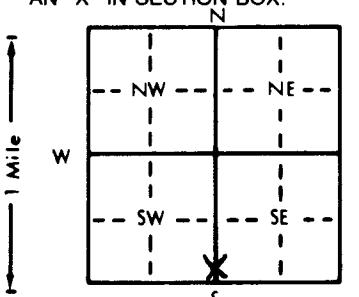


1 LOCATION OF WATER WELL: County: Saline Fraction SW 1/4 SW 1/4 SE 1/4 Section Number 32 Township Number T 14 S Range Number R 1 EW

Distance and direction from nearest town or city street address of well if located within city?
Great Plains Manufacturing facility

2 WATER WELL OWNER: Great Plains Manufacturing, Inc.
 RR#, St. Address, Box # : 244 North Hugh Board of Agriculture, Division of Water Resources
 City, State, ZIP Code : Kipp, Kansas 67401 Application Number:

3 LOCATE WELL'S LOCATION WITH AN "X" IN SECTION BOX:


4 DEPTH OF COMPLETED WELL: 32 ft. ELEVATION: ft.
 Depth(s) Groundwater Encountered 1. 18 ft. 2. ft. 3. ft.
 WELL'S STATIC WATER LEVEL ft. below land surface measured on mo/day/yr
 Pump test data: Well water was ft. after hours pumping gpm
 Est. Yield gpm: Well water was ft. after hours pumping gpm
 Bore Hole Diameter: 8.5 in. to 35 in. and in. to in. ft.
 WELL WATER TO BE USED AS: 5 Public water supply 8 Air conditioning 11 Injection well
 1 Domestic 3 Feedlot 6 Oil field water supply 9 Dewatering 12 Other (Specify below)
 2 Irrigation 4 Industrial 7 Lawn and garden only 10 Monitoring well
 Was a chemical/bacteriological sample submitted to Department? Yes..... No XX.....; If yes, mo/day/yr sample was submitted
 Water Well Disinfected? Yes No XX

5 TYPE OF BLANK CASING USED:
 1 Steel 3 RMP (SR) 5 Wrought iron 8 Concrete tile CASING JOINTS: Glued Clamped
2 PVC 4 ABS 7 Fiberglass 9 Other (specify below) Welded
 Blank casing diameter 2 in. to 17 ft., Dia in. to ft., Dia in. to ft.
 Casing height above land surface 24 in., weight lbs./ft. Wall thickness or gauge No. Sch. 40
 TYPE OF SCREEN OR PERFORATION MATERIAL:
 1 Steel 3 Stainless steel 5 Fiberglass 8 RMP (SR) 10 Asbestos-cement
 2 Brass 4 Galvanized steel 6 Concrete tile 9 ABS 11 Other (specify)
 SCREEN OR PERFORATION OPENINGS ARE:
 1 Continuous slot 3 Mill slot .010 5 Gauzed wrapped 8 Saw cut 11 None (open hole)
 2 Louvered shutter 4 Key punched 6 Wire wrapped 9 Drilled holes
 7 Torch cut 10 Other (specify)
 SCREEN-PERFORATED INTERVALS: From 32 ft. to 18 ft., From ft. to ft.
 From ft. to ft., From ft. to ft.
 GRAVEL PACK INTERVALS: From 35 ft. to 17 ft., From ft. to ft.
 From ft. to ft., From ft. to ft.

6 GROUT MATERIAL: 1 Neat cement 2 Cement grout 3 Bentonite 4 Other
 Grout Intervals: From 17 ft. to 4(bent) ft., From 4 ft. to 0 (cement) ft., From ft. to ft.
 What is the nearest source of possible contamination:
 1 Septic tank 4 Lateral lines 7 Pit privy 10 Livestock pens 14 Abandoned water well
 2 Sewer lines 5 Cess pool 8 Sewage lagoon 11 Fuel storage 15 Oil well/Gas well
 3 Watertight sewer lines 6 Seepage pit 9 Feedyard 12 Fertilizer storage 16 Other (specify below)
 13 Insecticide storage
 Direction from well? 50 How many feet? West

FROM	TO	LITHOLOGIC LOG	FROM	TO	PLUGGING INTERVALS
0	2	Top soil			
2	6.5	Clay - gray, plastic			
6.5	10	Clay - silty, brown			
10	13	Clay - silty, tan, gray clay zones			
13	17	Silt - clayey, brown, sandy			
17	23	Gravel - clayey, brown			
23	24	Clay - brown			
24	32	Sand - fine, clay seams			
32	35	Shale - Wellington			

7 CONTRACTOR'S OR LANDOWNER'S CERTIFICATION: This water well was (1) constructed, (2) reconstructed, or (3) plugged under my jurisdiction and was completed on (mo/day/year) 10-23-92 and this record is true to the best of my knowledge and belief. Kansas Water Well Contractor's License No. 527 This Water Well Record was completed on (mo/day/yr) 10-26-92 under the business name of GeoCore Services, Inc. by (signature) Dale A. Roll

INSTRUCTIONS: Use typewriter or ball point pen. PLEASE PRESS FIRMLY and PRINT clearly. Please fill in blanks, underline or circle the correct answers. Send top three copies to Kansas Department of Health and Environment, Bureau of Water, Topeka, Kansas 66620-0001. Telephone: 913-296-5545. Send one to WATER WELL OWNER and retain one for your records.

OFFICE USE ONLY T R EW SEC 1/4 1/4 1/4