


1 LOCATION OF WATER WELL: Fraction SW 1/4 NW 1/4 NE 1/4 Section Number 19 Township Number T 14 S Range Number R 10 EW

Distance and direction from nearest town or city street address of well if located within city?
 530 26th Street, Wilson, Ks. 67490 MW# 8

2 WATER WELL OWNER: Charles Johnson
 RR#, St. Address, Box # : 121 S Washington Board of Agriculture, Division of Water Resources
 City, State, ZIP Code : Mentor, Ks. 67465 Application Number:

3 LOCATE WELL'S LOCATION WITH AN "X" IN SECTION BOX:

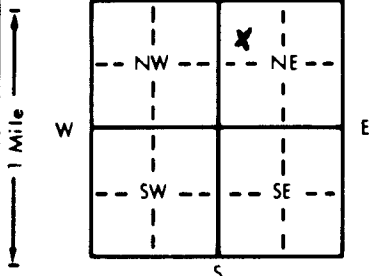

4 DEPTH OF COMPLETED WELL: 55 ft. ELEVATION:

Depth(s) Groundwater Encountered 1. 44 ft. 2. ft. 3. ft.
 WELL'S STATIC WATER LEVEL . 43.83 ft. below land surface measured on mo/day/yr . 5-10-91
 Pump test data: Well water was . ft. after . hours pumping . gpm
 Est. Yield . gpm: Well water was . ft. after . hours pumping . gpm
 Bore Hole Diameter. 7. 5/8 . in. to . 5.5 . ft., and . in. to . ft.
 WELL WATER TO BE USED AS: 5 Public water supply 8 Air conditioning 11 Injection well
 1 Domestic 3 Feedlot 6 Oil field water supply 9 Dewatering 12 Other (Specify below)
 2 Irrigation 4 Industrial 7 Lawn and garden only 10 Monitoring well
 Was a chemical/bacteriological sample submitted to Department? Yes . No . If yes, mo/day/yr sample was submitted
 Water Well Disinfected? Yes No

5 TYPE OF BLANK CASING USED: 1 Steel 2 PVC 3 RMP (SR) 4 ABS 5 Wrought iron 6 Asbestos-Cement 7 Fiberglass 8 Concrete tile 9 Other (specify below) CASING JOINTS: Glued . Clamped . Welded . Threaded .

Blank casing diameter . 2 . in. to . 34 . ft., Dia . in. to . ft., Dia . in. to . ft.
 Casing height above land surface . 0 . in., weight . lbs./ft. Wall thickness or gauge No. . Sch. 40 .

TYPE OF SCREEN OR PERFORATION MATERIAL: 1 Steel 2 Brass 3 Stainless steel 4 Galvanized steel 5 Fiberglass 6 Concrete tile 7 PVC 8 RMP (SR) 9 ABS 10 Asbestos-cement 11 Other (specify) 12 None used (open hole)

SCREEN OR PERFORATION OPENINGS ARE: 1 Continuous slot 2 Louvered shutter 3 Mill slot 4 Key punched 5 Gauzed wrapped 6 Wire wrapped 7 Torch cut 8 Saw cut 9 Drilled holes 10 Other (specify) 11 None (open hole)

SCREEN-PERFORATED INTERVALS: From . 34 . ft. to . 54 . ft., From . ft. to . ft., From . ft. to . ft.
 GRAVEL PACK INTERVALS: From . 32 . ft. to . 54 . ft., From . ft. to . ft., From . ft. to . ft.

6 GROUT MATERIAL: 1 Neat cement 2 Cement grout 3 Bentonite 4 Other
 Grout Intervals: From . 0 . ft. to . 29 (cement) ft., From . 29 . ft. to . 32 (bent) ft., From . ft. to . ft.

What is the nearest source of possible contamination:
 1 Septic tank 2 Sewer lines 3 Watertight sewer lines 4 Lateral lines 5 Cess pool 6 Seepage pit 7 Pit privy 8 Sewage lagoon 9 Feedyard 10 Livestock pens 11 Fuel storage 12 Fertilizer storage 13 Insecticide storage 14 Abandoned water well 15 Oil well/Gas well 16 Other (specify below)

Direction from well? nw How many feet? 120

FROM	TO	LITHOLOGIC LOG	FROM	TO	PLUGGING INTERVALS
0	4	Top soil, black			
4	10	Clay, dark brown, silty			Flush-mount well cover
10	19	Clay, light brown, silty, sandy			
19	20	Sand, light brown, silty, clayey			
20	55	Sand, tan to grey, fine to coarse			

7 CONTRACTOR'S OR LANDOWNER'S CERTIFICATION: This water well was (1) constructed (2) reconstructed, or (3) plugged under my jurisdiction and was completed on (mo/day/year) . 5-2-91 . and this record is true to the best of my knowledge and belief. Kansas Water Well Contractor's License No. . 527 . This Water Well Record was completed on (mo/day/yr) . 5-15-91 . under the business name of GeoCore Services, Inc. by (signature) Dale A. Holt

OFFICE USE ONLY
T
R
EW
SEC.
1/4
1/4
1/4