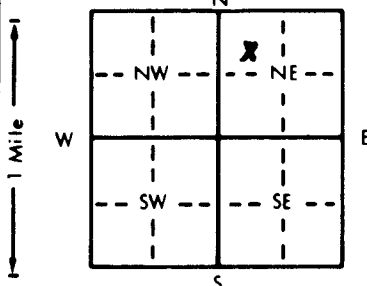


1 LOCATION OF WATER WELL: Fraction SW 1/4 NW 1/4 NE 1/4 Section Number 19 Township Number T 14 S Range Number R 10 EW

Distance and direction from nearest town or city street address of well if located within city?  
 530 26th Street, Wilson, Ks. 67490 MW# 1

2 WATER WELL OWNER: Mr. Charles Johnson  
 RR#, St. Address, Box # : 121 S Washington Board of Agriculture, Division of Water Resources  
 City, State, ZIP Code : Mentor, Ks. 67465 Application Number:

3 LOCATE WELL'S LOCATION WITH AN "X" IN SECTION BOX:  
  
 4 DEPTH OF COMPLETED WELL... 55 ft. ELEVATION:  
 Depth(s) Groundwater Encountered 1... 44 ft. 2... ft. 3... ft.  
 WELL'S STATIC WATER LEVEL... 43.97 ft. below land surface measured on mo/day/yr... 5-10-91.  
 Pump test data: Well water was... ft. after... hours pumping... gpm  
 Est. Yield... gpm: Well water was... ft. after... hours pumping... gpm  
 Bore Hole Diameter. 7.5/8 in. to... 55 ft., and... in. to... ft.  
 WELL WATER TO BE USED AS:  
 5 Public water supply 8 Air conditioning 11 Injection well  
 1 Domestic 3 Feedlot 6 Oil field water supply 9 Dewatering 12 Other (Specify below)  
 2 Irrigation 4 Industrial 7 Lawn and garden only 10 Monitoring well  
 Was a chemical/bacteriological sample submitted to Department? Yes... No... If yes, mo/day/yr sample was submitted  
 Water Well Disinfected? Yes No

5 TYPE OF BLANK CASING USED:  
 1 Steel 3 RMP (SR) 5 Wrought iron 8 Concrete tile CASING JOINTS: Glued... Clamped...  
 2 PVC 4 ABS 6 Asbestos-Cement 9 Other (specify below) Welded...  
 7 Fiberglass Threaded...  
 Blank casing diameter... 2 in. to... 34 ft., Dia... in. to... ft., Dia... in. to... ft.  
 Casing height above land surface... 0 in., weight... lbs./ft. Wall thickness or gauge No. Sch. 40  
 TYPE OF SCREEN OR PERFORATION MATERIAL:  
 1 Steel 3 Stainless steel 5 Fiberglass 7 PVC 10 Asbestos-cement  
 2 Brass 4 Galvanized steel 6 Concrete tile 8 RMP (SR) 11 Other (specify)  
 12 None used (open hole)  
 SCREEN OR PERFORATION OPENINGS ARE:  
 1 Continuous slot 3 Mill slot 5 Gauzed wrapped 8 Saw cut 11 None (open hole)  
 2 Louvered shutter 4 Key punched 6 Wire wrapped 9 Drilled holes  
 7 Torch cut 10 Other (specify)  
 SCREEN-PERFORATED INTERVALS: From... 34 ft. to... 54 ft., From... ft. to... ft.  
 GRAVEL PACK INTERVALS: From... 32 ft. to... 54 ft., From... ft. to... ft.

6 GROUT MATERIAL: 1 Neat cement 2 Cement grout 3 Bentonite 4 Other  
 Grout Intervals: From... 0 ft. to... 27 (cement) ft., From 27 (bent) ft. to... 32 ft., From... ft. to... ft.  
 What is the nearest source of possible contamination:  
 1 Septic tank 4 Lateral lines 7 Pit privy 10 Livestock pens 14 Abandoned water well  
 2 Sewer lines 5 Cess pool 8 Sewage lagoon 11 Fuel storage 15 Oil well/Gas well  
 3 Watertight sewer lines 6 Seepage pit 9 Feedyard 12 Fertilizer storage 16 Other (specify below)  
 13 Insecticide storage  
 Direction from well? Over removed U.S.T. How many feet? 0

FROM	TO	LITHOLOGIC LOG	FROM	TO	PLUGGING INTERVALS
0	4	Clay, yellowish black			
4	9	Clay, black			
9	11	Clay, medium brown			
11	19	Sand, fine, light brown, silty			
19	22	Sand, medium to coarse, grey			
22	30	Sand, medium, whitish yellow			
30	55	Sand, tan to grey			Flush-mount well cover

7 CONTRACTOR'S OR LANDOWNER'S CERTIFICATION: This water well was (1) constructed, (2) reconstructed, or (3) plugged under my jurisdiction and was completed on (mo/day/year) 4-30-91 and this record is true to the best of my knowledge and belief. Kansas Water Well Contractor's License No. 527 This Water Well Record was completed on (mo/day/yr) 5-14-91 under the business name of GeoCore Services, Inc. by (signature) Dale Abel

OFFICE USE ONLY  
T  
R  
EW  
SEC.  
1/4  
1/4  
1/4