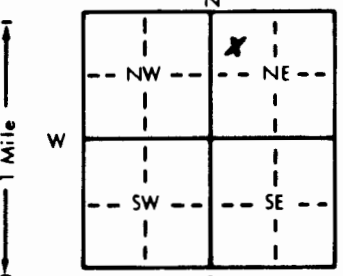


1 LOCATION OF WATER WELL: Fraction Section Number Township Number Range Number
 County: **Ellsworth** SW ¼ NW ¼ NE ¼ 19 T 14 S R 10 **EW**

Distance and direction from nearest town or city street address of well if located within city?
530 26th Street, Wilson, Kansas 67490 MW#2

2 WATER WELL OWNER: **Charles Johnson**
 RR#, St. Address, Box # : **121 S Washington** Board of Agriculture, Division of Water Resources
 City, State, ZIP Code : **Mentor, Ks. 67465** Application Number:

3 LOCATE WELL'S LOCATION WITH AN "X" IN SECTION BOX:

 4 DEPTH OF COMPLETED WELL... **55** ft. ELEVATION:
 Depth(s) Groundwater Encountered 1. **44** ft. 2. ft. 3. ft.
 WELL'S STATIC WATER LEVEL **43.09** ft. below land surface measured on mo/day/yr **5-10-91**
 Pump test data: Well water was ft. after hours pumping gpm
 Est. Yield gpm: Well water was ft. after hours pumping gpm
 Bore Hole Diameter. **7 5/8** in. to **55** ft., and in. to ft.
 WELL WATER TO BE USED AS:
 5 Public water supply 8 Air conditioning 11 Injection well
 1 Domestic 3 Feedlot 6 Oil field water supply 9 Dewatering 12 Other (Specify below)
 2 Irrigation 4 Industrial 7 Lawn and garden only **10 Monitoring well**
 Was a chemical/bacteriological sample submitted to Department? Yes.....No..... If yes, mo/day/yr sample was submitted
 Water Well Disinfected? Yes No

5 TYPE OF BLANK CASING USED:
 1 Steel 3 RMP (SR) 5 Wrought iron 8 Concrete tile CASING JOINTS: Glued.....Clamped.....
2 PVC 4 ABS 6 Asbestos-Cement 9 Other (specify below) Welded.....
 7 Fiberglass Threaded.....
 Blank casing diameter **2** in. to **34** ft., Dia. in. to ft., Dia. in. to ft.
 Casing height above land surface **0** in., weight lbs./ft. Wall thickness or gauge No. **Sch 40**
 TYPE OF SCREEN OR PERFORATION MATERIAL:
 1 Steel 3 Stainless steel 5 Fiberglass 8 RMP (SR) 10 Asbestos-cement
 2 Brass 4 Galvanized steel 6 Concrete tile 9 ABS 11 Other (specify).....
 12 None used (open hole)
 SCREEN OR PERFORATION OPENINGS ARE:
 1 Continuous slot **3 Mill slot** 5 Gauzed wrapped 8 Saw cut 11 None (open hole)
 2 Louvered shutter 4 Key punched 6 Wire wrapped 9 Drilled holes
 7 Torch cut 10 Other (specify).....
 SCREEN-PERFORATED INTERVALS: From **34** ft. to **54** ft., From ft. to ft.
 From ft. to ft., From ft. to ft.
 GRAVEL PACK INTERVALS: From **32** ft. to **54** ft., From ft. to ft.
 From ft. to ft., From ft. to ft.

6 GROUT MATERIAL: 1 Neat cement **2 Cement grout** **3 Bentonite** 4 Other.....
 Grout intervals: From **0** ft. to **29 (cement)** From **29** ft. to **32 (bent)** ft., From ft. to ft.
 What is the nearest source of possible contamination:
 1 Septic tank 4 Lateral lines 7 Pit privy **10 Livestock pens** 14 Abandoned water well
 2 Sewer lines 5 Cess pool 8 Sewage lagoon **11 Fuel storage** 15 Oil well/Gas well
 3 Watertight sewer lines 6 Seepage pit 9 Feedyard 12 Fertilizer storage 16 Other (specify below)
 13 Insecticide storage
 Direction from well? **NW** How many feet? **40**

FROM	TO	LITHOLOGIC LOG	FROM	TO	PLUGGING INTERVALS
0	2	Top soil, black			
2	12	Clay, medium brown, sandy & silty			
12	25	Sand, medium brown, clayey & silty, limestone fragments			
25	55	Sand, tan to grey			Flush mount well cover

7 CONTRACTOR'S OR LANDOWNER'S CERTIFICATION: This water well was **(1) constructed**, (2) reconstructed, or (3) plugged under my jurisdiction and was completed on (mo/day/year) **5-1-91** and this record is true to the best of my knowledge and belief. Kansas Water Well Contractor's License No. **527**. This Water Well Record was completed on (mo/day/yr) **5-14-91** under the business name of **GeoCore Services, Inc.** by (signature) *Dale A. Pitt*

OFFICE USE ONLY
T
R
EW
SEC.
1/4
1/4
1/4