


1 LOCATION OF WATER WELL: Fraction Section Number Township Number Range Number
 County: **Ellsworth** SW ¼ NW ¼ NE ¼ 19 T 14 S R 10 EW

Distance and direction from nearest town or city street address of well if located within city?
530 26th Street, Wilson, Ks. 67490 MW#3

2 WATER WELL OWNER: **Charles Johnson**
 RR#, St. Address, Box # : **121 S Washington** Board of Agriculture, Division of Water Resources
 City, State, ZIP Code : **Mentor, Ks. 67465** Application Number:

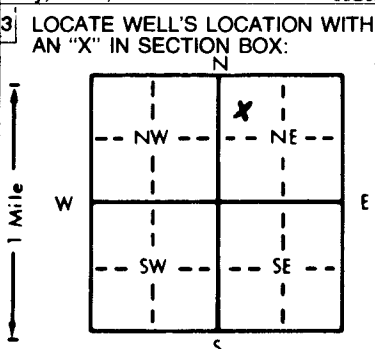

4 DEPTH OF COMPLETED WELL: **55** ft. ELEVATION:
 Depth(s) Groundwater Encountered 1. **44** ft. 2. ft. 3. ft.
 WELL'S STATIC WATER LEVEL **44.30** ft. below land surface measured on **mo/day/yr 5-10-91**
 Pump test data: Well water was ft. after hours pumping gpm
 Est. Yield gpm: Well water was ft. after hours pumping gpm
 Bore Hole Diameter: **7.5/8** in. to **55** ft., and in. to ft.
 WELL WATER TO BE USED AS:
 5 Public water supply 8 Air conditioning 11 Injection well
 1 Domestic 3 Feedlot 6 Oil field water supply 9 Dewatering 12 Other (Specify below)
 2 Irrigation 4 Industrial 7 Lawn and garden only **10 Monitoring well**
 Was a chemical/bacteriological sample submitted to Department? Yes No If yes, mo/day/yr sample was submitted
 Water Well Disinfected? Yes No

5 TYPE OF BLANK CASING USED:
 1 Steel 3 RMP (SR) 5 Wrought iron 8 Concrete tile CASING JOINTS: Glued Clamped
2 PVC 4 ABS 7 Fiberglass 9 Other (specify below) Welded
 Blank casing diameter **2** in. to **33.5** ft., Dia. in. to ft., Dia. in. to ft.
 Casing height above land surface **24** in., weight lbs./ft. Wall thickness or gauge No. **Sch. 40**

TYPE OF SCREEN OR PERFORATION MATERIAL:
 1 Steel 3 Stainless steel 5 Fiberglass **7 PVC** 10 Asbestos-cement
 2 Brass 4 Galvanized steel 6 Concrete tile 9 ABS 11 Other (specify)

SCREEN OR PERFORATION OPENINGS ARE:
 1 Continuous slot **3 Mill slot** 5 Gauzed wrapped 8 Saw cut 11 None (open hole)
 2 Louvered shutter 4 Key punched 6 Wire wrapped 9 Drilled holes
 7 Torch cut 10 Other (specify)

SCREEN-PERFORATED INTERVALS: From **33.5** ft. to **53.5** ft., From ft. to ft.
 GRAVEL PACK INTERVALS: From **29.5** ft. to **53.5** ft., From ft. to ft.

6 GROUT MATERIAL: 1 Neat cement **2 Cement grout** **3 Bentonite** 4 Other
 Grout Intervals: From **0** ft. to **26.5 (cement)** ft. From **26.5** ft. to **29.5 (bent)** ft. From ft. to ft.
 What is the nearest source of possible contamination:
 1 Septic tank 4 Lateral lines 7 Pit privy **11 Fuel storage** 14 Abandoned water well
 2 Sewer lines 5 Cess pool 8 Sewage lagoon 12 Fertilizer storage 15 Oil well/Gas well
 3 Watertight sewer lines 6 Seepage pit 9 Feedyard 13 Insecticide storage 16 Other (specify below)

Direction from well? **N** How many feet? **300**

FROM	TO	LITHOLOGIC LOG	FROM	TO	PLUGGING INTERVALS
0	4	Top soil, black			
4	14	Clay, silty, dark brown			
14	16	Sand, very fine, medium brown			
16	22	Clay, sandy, med brown			
22	25	Sand, fine, whitish			
25	35	Sand, fine to coarse, white to red			Above ground steel well cover
35	36	Clay, sandy, silty dark brown			
36	55	Sand, coarse, white to red			

7 CONTRACTOR'S OR LANDOWNER'S CERTIFICATION: This water well was **(1) constructed**, (2) reconstructed, or (3) plugged under my jurisdiction and was completed on (mo/day/year) **5-7-91** and this record is true to the best of my knowledge and belief. Kansas Water Well Contractor's License No. **527** This Water Well Record was completed on (mo/day/yr) **5-15-91** under the business name of **GeoCore Services, Inc.** by (signature) *Dale Bell*

INSTRUCTIONS: Use typewriter or ball point pen. PLEASE PRESS FIRMLY and PRINT clearly. Please fill in blanks, underline or circle the correct answers. Send top three copies to Kansas Department of Health and Environment, Bureau of Water, Topeka, Kansas 66620-7320. Telephone: 913-296-5545. Send one to WATER WELL OWNER and retain one for your records.

OFFICE USE ONLY
T
R
EM
SEC.
1/4
1/4
1/4