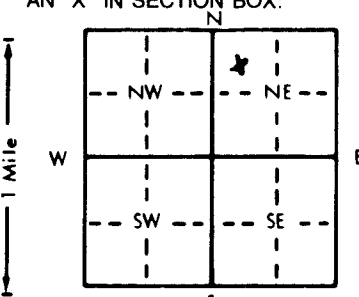


1 LOCATION OF WATER WELL: Fraction SW 1/4 NW 1/4 NE 1/4 Section Number 19 Township Number T 14 S Range Number R 10 EW

Distance and direction from nearest town or city street address of well if located within city? 530 26th Street, Wilson, Ks. 67490 MW#12

2 WATER WELL OWNER: Charles Johnson
 RR#, St. Address, Box # : 121 S Washington Board of Agriculture, Division of Water Resources
 City, State, ZIP Code : Mentor, Ks. 67465 Application Number:

3 LOCATE WELL'S LOCATION WITH AN "X" IN SECTION BOX:  4 DEPTH OF COMPLETED WELL: 54 ft. ELEVATION: ...
 Depth(s) Groundwater Encountered 1. 44 ft. 2. ... ft. 3. ... ft.
 WELL'S STATIC WATER LEVEL . 44.89 ft. below land surface measured on mo/day/yr 5-10-91
 Pump test data: Well water was ... ft. after ... hours pumping ... gpm
 Est. Yield ... gpm: Well water was ... ft. after ... hours pumping ... gpm
 Bore Hole Diameter . 7. 5/8 . in. to . 54 . ft., and . . in. to . . ft.
 WELL WATER TO BE USED AS: 5 Public water supply 8 Air conditioning 11 Injection well
 1 Domestic 3 Feedlot 6 Oil field water supply 9 Dewatering 12 Other (Specify below)
 2 Irrigation 4 Industrial 7 Lawn and garden only 10 Monitoring well
 Was a chemical/bacteriological sample submitted to Department? Yes.....No.....
 Water Well Disinfected? Yes No

5 TYPE OF BLANK CASING USED: 1 Steel 2 PVC 3 RMP (SR) 4 ABS 5 Wrought iron 6 Asbestos-Cement 7 Fiberglass 8 Concrete tile 9 Other (specify below) CASING JOINTS: Glued Clamped Welded Threaded
 Blank casing diameter . 2 . in. to . 33 . ft., Dia . . in. to . . ft., Dia . . in. to . . ft.
 Casing height above land surface . 24 . in., weight . . lbs./ft. Wall thickness or gauge No. sch 40
 TYPE OF SCREEN OR PERFORATION MATERIAL: 1 Steel 2 Brass 3 Stainless steel 4 Galvanized steel 5 Fiberglass 6 Concrete tile 7 PVC 8 RMP (SR) 9 ABS 10 Asbestos-cement 11 Other (specify) 12 None used (open hole)
 SCREEN OR PERFORATION OPENINGS ARE: 1 Continuous slot 2 Louvered shutter 3 Mill slot 4 Key punched 5 Gauzed wrapped 6 Wire wrapped 7 Torch cut 8 Saw cut 9 Drilled holes 10 Other (specify) 11 None (open hole)
 SCREEN-PERFORATED INTERVALS: From . 33 . ft. to . 53 . ft., From . . ft. to . . ft.
 GRAVEL PACK INTERVALS: From . 31 . ft. to . 53 . ft., From . . ft. to . . ft.

6 GROUT MATERIAL: 1 Neat cement 2 Cement grout 3 Bentonite 4 Other
 Grout Intervals: From . 0 . ft. to . 29.5 (cement) ft., From . 29.5 . ft. to . 31 (bent) ft., From . . ft. to . . ft.
 What is the nearest source of possible contamination: 1 Septic tank 2 Sewer lines 3 Watertight sewer lines 4 Lateral lines 5 Cess pool 6 Seepage pit 7 Pit privy 8 Sewage lagoon 9 Feedyard 10 Livestock pens 11 Fuel storage 12 Fertilizer storage 13 Insecticide storage 14 Abandoned water well 15 Oil well/Gas well 16 Other (specify below)

Direction from well? N

FROM	TO	LITHOLOGIC LOG	FROM	TO	PLUGGING INTERVALS
0	5	Top soil, black			
5	12	Clay, silty, black			
12	19	Clay, silty, sandy, brown			
19	21	Sand, very fine, silty, brown			
21	27	Clay, silty, sandy, brown			Above-ground well cover
27	34	Sand, medium to coarse, white to red			
34	35	Clay, silty, brown			
35	54	Sand, coarse to granular, white to red			

7 CONTRACTOR'S OR LANDOWNER'S CERTIFICATION: This water well was (1) constructed, (2) reconstructed, or (3) plugged under my jurisdiction and was completed on (mo/day/year) 5-9-91 and this record is true to the best of my knowledge and belief. Kansas Water Well Contractor's License No. 527 This Water Well Record was completed on (mo/day/yr) 5-15-91 under the business name of GeoCore Services, Inc. by (signature) Dale A. Bell

INSTRUCTIONS: Use typewriter or ball point pen. PLEASE PRESS FIRMLY and PRINT clearly. Please fill in blanks, underline or circle the correct answers. Send top three copies to Kansas Department of Health and Environment, Bureau of Water, Topeka, Kansas 66620-7320. Telephone: 913-296-5545. Send one to WATER WELL OWNER and retain one for your records.

OFFICE USE ONLY
T
R
EW
SEC.
1/4
1/4
1/4