CORRECTION TO WATER WELL RECORD (WWC-5)

The following correction(s) was made to the attached WWC-5 log, in order to file the item or to rectify lacking or incorrect information.

Fraction (1/4 1/4 1/4) Section-Township-Range changed:

listed as _____

changed to _____

Other changes: Initial statements: Barton County

Changed to: Ellsworth County

Comments: _____

verification method: Written & legal descriptions, and Wilson 1:24,000 topo. map. initials: DRL date: 8/2/2000

submitted by: Kansas Geological Survey, Data Resources Library, 1930 Constant Ave., Lawrence, KS 66047-3726
to: Kansas Dept of Health & Environment Bureau of Water Industrial Programs, Bldg 283, Forbes Field, KS 66620

WATER WELL RECORD Form WWC-5 KSA 82a-1212

1 LOCATION OF WATER WELL:	Fraction	Section Number	Township Number	Range Number
County: Barton	SW ¼ SW ¼ SW ¼	30	T 14 S	R 10 E/W

Distance and direction from nearest town or city street address of well if located within city?
1¼ mi South of Wilson on Wilson Blacktop East in to

2 WATER WELL OWNER: James Volcek
RR#, St. Address, Box # : 1709 Hwy 281
City, State, ZIP Code : Russell Ks 67

Board of Agriculture, Division of Water Resources
Application Number:

3 LOCATE WELL'S LOCATION WITH AN "X" IN SECTION BOX:

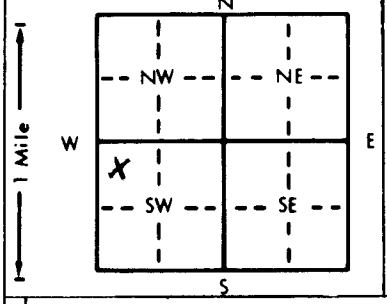

4 DEPTH OF COMPLETED WELL 100 ft. ELEVATION:
Depth(s) Groundwater Encountered 1. 35 ft. 2. 85 ft. 3. ft.
WELL'S STATIC WATER LEVEL 45 ft. below land surface measured on mo/day/yr 6-11-00
Pump test data: Well water was 40 ft. after 2 hours pumping 12 gpm
Est. Yield 25 gpm: Well water was 85 ft. after 1 hours pumping 25 gpm
Bore Hole Diameter 8¾ in. to 100 ft., and in. to ft.
WELL WATER TO BE USED AS: 5 Public water supply 8 Air conditioning 11 Injection well
1 Domestic 3 Feedlot 6 Oil field water supply 9 Dewatering 12 Other (Specify below)
2 Irrigation 4 Industrial X Lawn and garden only 10 Monitoring well
Was a chemical/bacteriological sample submitted to Department? Yes ..... No ....; If yes, mo/day/yr sample was submitted
Water Well Disinfected? Yes X No

5 TYPE OF BLANK CASING USED: 5 Wrought iron 8 Concrete tile CASING JOINTS: Glued X Clamped
1 Steel 3 RMP (SR) 6 Asbestos-Cement 9 Other (specify below) Welded
X PVC 4 ABS 7 Fiberglass Threaded
Blank casing diameter 5 in. to 100 ft., Dia in. to ft., Dia in. to ft.
Casing height above land surface 18 in., weight Sch 40 lbs./ft. Wall thickness or gauge No.

TYPE OF SCREEN OR PERFORATION MATERIAL: X PVC 10 Asbestos-cement
1 Steel 3 Stainless steel 5 Fiberglass 8 RMP (SR) 11 Other (specify)
2 Brass 4 Galvanized steel 6 Concrete tile 9 ABS 12 None used (open hole)

SCREEN OR PERFORATION OPENINGS ARE: 5 Gauzed wrapped X Saw cut 11 None (open hole)
1 Continuous slot 3 Mill slot 6 Wire wrapped 9 Drilled holes
2 Louvered shutter 4 Key punched 7 Torch cut 10 Other (specify)

SCREEN-PERFORATED INTERVALS: From 100 ft. to 75 ft., From ft. to ft.
From ft. to ft., From ft. to ft.
GRAVEL PACK INTERVALS: From 100 ft. to 60 ft., From ft. to ft.
From ft. to ft., From ft. to ft.

6 GROUT MATERIAL: 1 Neat cement 2 Cement grout X Bentonite 4 Other
Grout Intervals: From 60 ft. to 0 ft., From ft. to ft., From ft. to ft.

What is the nearest source of possible contamination:
1 Septic tank 4 Lateral lines 7 Pit privy 10 Livestock pens 14 Abandoned water well
2 Sewer lines 5 Cess pool 8 Sewage lagoon 11 Fuel storage 15 Oil well/Gas well
3 Watertight sewer lines 6 Seepage pit 9 Feedyard 12 Fertilizer storage 16 Other (specify below)
13 Insecticide storage
Direction from well? How many feet?

FROM	TO	LITHOLOGIC LOG	FROM	TO	PLUGGING INTERVALS
0	3	Soil			
3	12	Clay			
12	20	River Sand			
20	34	Yellow Clay			
34	35	White Sandy Clay			
35	65	Red & White Clay			
65	75	Red Clay			
75	80	Tan Ayrite			
80	85	Grey Blue Shale			
85	86	Sand rock Coarse			
86	100	Red Shale			

7 CONTRACTOR'S OR LANDOWNER'S CERTIFICATION: This water well was (1) X constructed, (2) reconstructed, or (3) plugged under my jurisdiction and was completed on (mo/day/year) 6-11-00 and this record is true to the best of my knowledge and belief. Kansas Water Well Contractor's License No. 660 This Water Well Record was completed on (mo/day/yr) 6-12-00 under the business name of Goodman Water Well Dlg by (signature) Jack Goodman

INSTRUCTIONS: Use typewriter or ball point pen. PLEASE PRESS FIRMLY and PRINT clearly. Please fill in blanks, underline or circle the correct answers. Send top three copies to Kansas Department of Health and Environment, Bureau of Water, Topeka, Kansas 66620-0001. Telephone: 913-296-5545. Send one to WATER WELL OWNER and retain one for your records.

OFFICE USE ONLY T R EW SEC. ¼ ¼ ¼