

MW-8

WATER WELL RECORD

Form WWC-5


Division of Water Resources App. No.

1 LOCATION OF WATER WELL: County: Ellsworth Fraction SE 1/4 NW 1/4 NE 1/4 Section Number 19 Township No. T 14 S Range Number R 10 E W

Street/Rural Address of Well Location; if unknown, distance & direction from nearest town or intersection: Access the street on the east side of Ave F from water tower

Global Positioning System (GPS) information: Latitude: 38.82605 Longitude: 98.47530 Elevation: Datum: WGS 84, NAD 83, NAD 27 Collection Method: GPS unit, Digital Map/Photo, Topographic Map, Land Survey

2 WATER WELL OWNER: City of Wilson RR#, Street Address, Box #: City Hall, 2407 Ave. E City, State, ZIP Code: PO Box 5, Wilson, KY. 60990

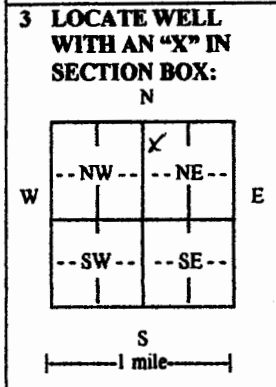

3 LOCATE WELL WITH AN 'X' IN SECTION BOX: 4 DEPTH OF COMPLETED WELL: 5.1 ft. Depth(s) Groundwater Encountered (1) 4.3 ft. (2) 8.8 ft. WELL'S STATIC WATER LEVEL 4.3 ft. below land surface measured on mo/day/yr. 

5 TYPE OF CASING USED: PVC CASING JOINTS: Threaded Casing diameter 2 in. to 3.6 ft. Diameter 2 in. to 3.6 ft. Diameter 2 in. to 3.6 ft. Casing height above land surface 0 in., Weight lbs./ft., Wall thickness or gauge No. 5. Casing height above land surface 0 in., Weight lbs./ft., Wall thickness or gauge No. 5. TYPE OF SCREEN OR PERFORATION MATERIAL: PVC SCREEN OR PERFORATION OPENINGS ARE: Mill slot SCREEN-PERFORATED INTERVALS: From 3.6 ft. to 5.1 ft. GRAVEL PACK INTERVALS: From 3.4 ft. to 5.1 ft.

6 GROUT MATERIAL: Bentonite Grout Intervals: From 0 ft. to 5.1 ft. What is the nearest source of possible contamination: Septic tank, Lateral lines, Pit privy, Livestock pens, Insecticide storage, Sewer lines, Cesspool, Sewage lagoon, Fuel storage, Abandoned water well, Watertight sewer lines, Seepage pit, Feedyard, Fertilizer storage, Oil well/gas well. Direction from well, Distance from well.

Table with columns: FROM, TO, LITHOLOGIC LOG, FROM, TO, LITHO. LOG (cont.) or PLUGGING INTERVALS. Rows contain depth intervals and lithological descriptions like 'Clay, brown, dry', 'Clay, brown, silty, damp', 'Clay, lbm, sandy, no JT', 'Sand, lbm, fgr, no JT', 'Sand, lbm, fgr-cgr, no JT', 'Sand, lbm, cgr, gravel, no JT', 'Sand & Gravel, wet'.

7 CONTRACTOR'S OR LANDOWNER'S CERTIFICATION: This water well was constructed, reconstructed, or plugged under my jurisdiction and was completed on (mo/day/year) 8-9-12 and this record is true to the best of my knowledge and belief. Kansas Water Well Contractor's License No. 604. This Water Well Record was completed on (mo/day/year) 9.11.12 under the business name of Env. Services, Inc. by (signature) Paul S. Smith.

INSTRUCTIONS: Use typewriter or ball point pen. PLEASE PRESS FIRMLY and PRINT clearly. Please fill in blanks and check the correct answers. Send three copies (white, blue, pink) to Kansas Department of Health and Environment, Bureau of Water, Geology Section, 1000 SW Jackson St., Suite 420, Topeka, Kansas 66612-1367. Telephone 785-296-5524. Send one copy to WATER WELL OWNER and retain one for your records. Include fee of \$5.00 for each constructed well. Visit us at http://www.kdheks.gov/waterwell/index.html.