

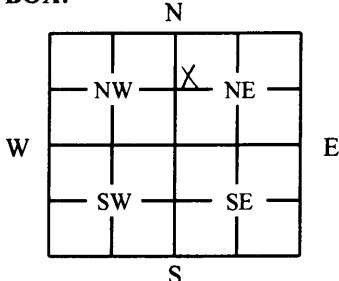
WATER WELL PLUGGING RECORD Form WWC-5P

KSA 82a-1212 ID NO. MW-3

1 LOCATION OF WATER WELL: County: <u>Ellsworth</u>	Fraction <u>SE 1/4 SW 1/4 NW 1/4 NE 1/4</u>	Section Number <u>19</u>	Township Number <u>14 S</u>	Range Number <u>10</u> <input type="checkbox"/> E <input checked="" type="checkbox"/> W
--	--	-----------------------------	--------------------------------	--

Street/Rural Address of Well Location; if unknown, distance and direction from nearest town or intersection. If at owner's address, check here <input type="checkbox"/> <u>2720 Avenue E, Wilson</u>	Global Positioning Systems (GPS) Information: Latitude: <u>38.824461</u> (in decimal degrees) Longitude: <u>-98.474276</u> (in decimal degrees) Elevation: _____ Datum: <input checked="" type="checkbox"/> WGS84 <input type="checkbox"/> NAD83 <input type="checkbox"/> NAD27 Collection Method: <input type="checkbox"/> GPS unit Make/Model: <u>Google Earth</u> <input checked="" type="checkbox"/> Digital Map/Photo <input type="checkbox"/> Topographic Map <input type="checkbox"/> Land Survey Est. Accuracy: <input type="checkbox"/> <3 m <input checked="" type="checkbox"/> 3-5 m <input type="checkbox"/> 5-15 m <input type="checkbox"/> >15 m
---	---

2 WATER WELL OWNER: <u>Kansas Dept of Health & Environ.</u> RR#, St. Address, Box # <u>1000 SW Jackson St., Suite 410</u> City, State ZIP Code <u>Topeka, KS 66612-1367</u>	
--	--

3 MARK WELL'S LOCATION WITH AN "X" IN SECTION BOX: 	4 DEPTH OF WELL: <u>54.86</u> ft. WELL'S STATIC WATER LEVEL: <u>43.20</u> ft. WELL WAS USED AS: <input type="checkbox"/> Domestic <input type="checkbox"/> Public Water Supply <input type="checkbox"/> Dewatering <input type="checkbox"/> Irrigation <input type="checkbox"/> Old Field Water Supply <input checked="" type="checkbox"/> Monitoring <input type="checkbox"/> Feedlot <input type="checkbox"/> Domestic (Lawn/Garden) <input type="checkbox"/> Injection Well <input type="checkbox"/> Industrial <input type="checkbox"/> Air Conditioning <input type="checkbox"/> Other _____ Was a chemical/bacteriological sample submitted to Department? <input type="checkbox"/> Yes <input checked="" type="checkbox"/> No
--	--

5 TYPE OF BLANK CASING USED: <input type="checkbox"/> Steel <input type="checkbox"/> RMP (SR) <input type="checkbox"/> Wrought <input type="checkbox"/> Fiberglass <input type="checkbox"/> Other: _____ <input checked="" type="checkbox"/> PVC <input type="checkbox"/> ABS <input type="checkbox"/> Asbestos/Cement <input type="checkbox"/> Concrete Tile _____	Blank casing diameter: <u>2</u> in. Was casing pulled? <input checked="" type="checkbox"/> Yes <input type="checkbox"/> No If Yes, how much <u>3'</u> Casing height above or below land surface: _____ in.
--	---

6 GROUT PLUG MATERIAL: <input type="checkbox"/> Neat cement <input type="checkbox"/> Cement grout <input checked="" type="checkbox"/> Bentonite <input type="checkbox"/> Other: _____ Grout Plug Intervals: From <u>3</u> ft. To <u>54.86</u> ft. From _____ ft. To _____ ft. From _____ ft. To _____ ft. What is the nearest source of possible contamination: <input type="checkbox"/> Septic tank <input type="checkbox"/> Seepage pit <input type="checkbox"/> Fuel storage <input checked="" type="checkbox"/> Other (specify below): <input type="checkbox"/> Sewer lines <input type="checkbox"/> Pit privy <input type="checkbox"/> Fertilizer storage <u>Contaminated site</u> <input type="checkbox"/> Watertight sewer lines <input type="checkbox"/> Sewage lagoon <input type="checkbox"/> Insecticide storage _____ <input type="checkbox"/> Lateral lines <input type="checkbox"/> Feedyard <input type="checkbox"/> Abandoned water well Direction from well: _____ <input type="checkbox"/> Cess pool <input type="checkbox"/> Livestock pens <input type="checkbox"/> Oil well/Gas well How many feet: _____	
--	--

FROM	TO	PLUGGING MATERIAL	FROM	TO	PLUGGING MATERIAL
0	0.5	Concrete			
0.5	3	Native soil			
3	54.86	Bentonite			MW-3

7 CONTRACTOR'S OR LANDOWNER'S CERTIFICATION: This water well was plugged under my jurisdiction and was completed on (mo/day/year) 6/29/2018 and this record is true to the best of my knowledge and belief. Kansas Water Well Contractor's License No. 527. This Water Well Record was completed on (mo/day/year) 7/3/2018 under the business name of GeoCore Inc. by (signature) Dan Bell.

INSTRUCTIONS: Use typewriter or ballpoint pen. Please press firmly and print clearly. Please fill in blanks, underline or circle the correct answers. Send one copy to Kansas Department of Health and Environment, Bureau of Water, Geology Section, 1000 SW Jackson St., Ste. 420, Topeka, Kansas 66612-1367. Telephone 785/296-5524. Send one to Water Well Owner and retain one for your records. Visit us at <http://www.kdheks.gov/waterwell/index.html>.

Ellsworth

SE SW NW NE

19-145-10W



Stop 2 Shop II
2720 Avenue E, Wilson

GPS Coordinates:

- MW-1: 38.824259, -98.474337
- MW-2: 38.824072, -98.474375
- MW-3: 38.824461, -98.474276
- MW-4: 38.824386, -98.474473
- MW-5: 38.824481, -98.474703

RECEIVED
JUL 11 2018
BUREAU OF WATER