


1 LOCATION OF WATER WELL: County: Russell Fraction: SE 1/4 SW 1/4 Section Number: 7 Township Number: T 14 S Range Number: R 11 E

Distance and direction from nearest town or city street address of well if located within city?  
318 Jellison St. Dorrance, KS. 67634

2 WATER WELL OWNER: Jerry Paser  
 RR#, St. Address, Box #: Box 43  
 City, State, ZIP Code: Dorrance, KS. 67634  
 Board of Agriculture, Division of Water Resources  
 Application Number:

3 LOCATE WELL'S LOCATION WITH AN "X" IN SECTION BOX:

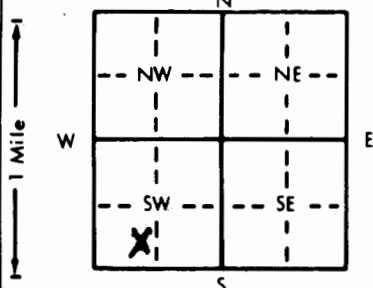

4 DEPTH OF COMPLETED WELL: 48' ft. ELEVATION:

Depth(s) Groundwater Encountered 1. 31' ft. 2. ft. 3. ft.  
 WELL'S STATIC WATER LEVEL 31' ft. below land surface measured on mo/day/yr 4/15/97  
 Pump test data: Well water was 33' ft. after 1 hours pumping 8 gpm  
 Est. Yield 100 gpm Well water was ft. after hours pumping gpm  
 Bore Hole Diameter 8 in. to 48' ft., and in. to ft.  
 WELL WATER TO BE USED AS:  
 5 Public water supply 8 Air conditioning 11 Injection well  
 1 Domestic 3 Feedlot 6 Oil field water supply 9 Dewatering  
 2 Irrigation 4 Industrial 7 Lawn and garden only 10 Monitoring well  
 Was a chemical/bacteriological sample submitted to Department? Yes X No X; If yes, mo/day/yr sample was submitted  
 Water Well Disinfected? Yes X No

5 TYPE OF BLANK CASING USED:  
 1 Steel 3 RMP (SR) 5 Wrought iron 8 Concrete tile CASING JOINTS: Glued Clamped  
 2 PVC 4 ABS 6 Asbestos-Cement 9 Other (specify below) Welded  
 7 Fiberglass Threaded

Blank casing diameter 5 in. to 28 ft., Dia. RB in. to ft., Dia. in. to ft.  
 Casing height above land surface 24 in., weight lbs./ft. Wall thickness or gauge No. SDR 26

TYPE OF SCREEN OR PERFORATION MATERIAL:  
 1 Steel 3 Stainless steel 5 Fiberglass 7 PVC 10 Asbestos-cement  
 2 Brass 4 Galvanized steel 6 Concrete tile 8 RMP (SR) 11 Other (specify)  
 9 ABS 12 None used (open hole)

SCREEN OR PERFORATION OPENINGS ARE:  
 1 Continuous slot 3 Mill slot 5 Gauzed wrapped 8 Saw cut 11 None (open hole)  
 2 Louvered shutter 4 Key punched 6 Wire wrapped 9 Drilled holes  
 7 Torch cut 48' 10 Other (specify) Factory Perforated

SCREEN-PERFORATED INTERVALS: From 28 ft. to 48 ft., From ft. to ft.  
 From ft. to ft., From ft. to ft.  
 GRAVEL PACK INTERVALS: From 24 ft. to 48 ft., From ft. to ft.  
 From ft. to ft., From ft. to ft.

6 GROUT MATERIAL: Neat cement 2 Cement grout 3 Bentonite 4 Other  
 Grout intervals: From 7 ft. to 20 ft., From ft. to ft., From ft. to ft.

What is the nearest source of possible contamination:  
 1 Septic tank 4 Lateral lines 7 Pit privy 10 Livestock pens 14 Abandoned water well  
 2 Sewer lines 5 Cess pool 8 Sewage lagoon 11 Fuel storage 15 Oil well/Gas well  
 3 Watertight sewer lines 6 Seepage pit 9 Feedyard 12 Fertilizer storage 16 Other (specify below)  
16 Other (specify below) SHOP Building

Direction from well? Southwest How many feet? 50'

FROM	TO	LITHOLOGIC LOG	FROM	TO	PLUGGING INTERVALS
0	10	Topsoil			
10	13	CLAY - Grey			
13	30	Sand - fine			
30	48	Sand - COARSE			

7 CONTRACTOR'S OR LANDOWNER'S CERTIFICATION: This water well was (1) constructed, (2) reconstructed, or (3) plugged under my jurisdiction and was completed on (mo/day/year) 4-7-97 and this record is true to the best of my knowledge and belief. Kansas Water Well Contractor's License No. 619 This Water Well Record was completed on (mo/day/yr) 4-8-97 under the business name of Bushell Waterwell Service by (signature) Don R Bushell