


1 LOCATION OF WATER WELL: Fraction SE 1/4 SW 1/4 SW 1/4 Section Number 7 Township Number T 14 S Range Number R 11 E 11
 County: Russell

Distance and direction from nearest town or city street address of well if located within city?
113 So. Main Dorrance, Ks. 67634

2 WATER WELL OWNER: Darrell Houston
 RR#, St. Address, Box #: 113 So Main Board of Agriculture, Division of Water Resources
 City, State, ZIP Code: Dorrance, Ks. 67634 Application Number:

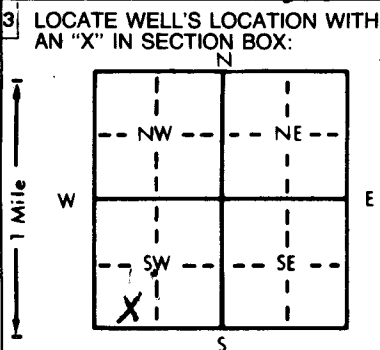

4 DEPTH OF COMPLETED WELL: 35' ft. ELEVATION: ft.
 Depth(s) Groundwater Encountered: 1, 25' ft. 2. ft. 3. ft.
 WELL'S STATIC WATER LEVEL: 25' ft. below land surface measured on mo/day/yr 4/21/97
 Pump test data: Well water was 28' ft. after 1 hours pumping 8 gpm
 Est. Yield: 10 to 12 gpm; Well water was ft. after hours pumping gpm
 Bore Hole Diameter: 8 in. to 35' ft. and in. to ft.
 WELL WATER TO BE USED AS:
 1 Domestic 3 Feedlot 6 Oil field water supply 9 Dewatering
 2 Irrigation 4 Industrial 7 Lawn and garden only 10 Monitoring well
 5 Public water supply 8 Air conditioning 11 Injection well
 12 Other (Specify below) yard & trees
 Was a chemical/bacteriological sample submitted to Department? Yes..... No X..... If yes, mo/day/yr sample was submitted
 Water Well Disinfected? Yes X No

5 TYPE OF BLANK CASING USED:
 1 Steel 3 RMP (SR) 5 Wrought iron 8 Concrete tile CASING JOINTS: Glued Clamped
2 PVC 4 ABS 6 Asbestos-Cement 9 Other (specify below) Welded
 Blank casing diameter: 5 in. to 25 ft., Dia in. to ft., Dia in. to ft.
 Casing height above land surface: 24 in., weight lbs./ft. Wall thickness or gauge No: SDR26
 TYPE OF SCREEN OR PERFORATION MATERIAL:
 1 Steel 3 Stainless steel 5 Fiberglass 7 PVC 10 Asbestos-cement
 2 Brass 4 Galvanized steel 6 Concrete tile 8 RMP (SR) 11 Other (specify below) Factory Perforated Error RB
 9 ABS 12 None used (open hole)
 SCREEN OR PERFORATION OPENINGS ARE:
 1 Continuous slot 3 Mill slot 5 Gauzed wrapped 8 Saw cut 11 None (open hole)
 2 Louvered shutter 4 Key punched 6 Wire wrapped 9 Drilled holes
 7 Torch cut 10 Other (specify) Factory Perforated
 SCREEN-PERFORATED INTERVALS: From 25' ft. to 35' ft., From ft. to ft.
 GRAVEL PACK INTERVALS: From 15' ft. to 35' ft., From ft. to ft.

6 GROUT MATERIAL: Neat cement 2 Cement grout 3 Bentonite 4 Other
 Grout Intervals: From 0 ft. to 20 ft., From ft. to ft., From ft. to ft.
 What is the nearest source of possible contamination:
 1 Septic tank 4 Lateral lines 7 Pit privy 10 Livestock pens 14 Abandoned water well
2 Sewer lines 5 Cess pool 8 Sewage lagoon 11 Fuel storage 15 Oil well/Gas well
 3 Watertight sewer lines 6 Seepage pit 9 Feedyard 12 Fertilizer storage 16 Other (specify below) 2nd Source: Water Run off
 13 Insecticide storage
 Direction from well? WEST How many feet? 50

FROM	TO	LITHOLOGIC LOG	FROM	TO	PLUGGING INTERVALS
0	8	Top SOIL			
8	10	CLAY - Grey			
10	30	SAND - FINE			
30	35	SAND - COARSE			

7 CONTRACTOR'S OR LANDOWNER'S CERTIFICATION: This water well was (1) constructed (2) reconstructed, or (3) plugged under my jurisdiction and was completed on (mo/day/year) 4/23/97 and this record is true to the best of my knowledge and belief. Kansas Water Well Contractor's License No. 6019 This Water Well Record was completed on (mo/day/yr) 4/24/97 under the business name of Bushell Well Service by (signature) Don R Bushell