


<b>1 LOCATION OF WATER WELL:</b>	Fraction	Section Number	Township Number	Range Number
County: <b>Russell</b>	<b>SE ¼ NE ¼ SW ¼</b>	<b>7</b>	<b>14S</b>	<b>11 W</b>

Distance and direction from nearest town or city street address of well if located within city?  
**601 Hwy 231**  
**Dorrance, Kansas**

<b>2 WATER WELL OWNER: Agco, Inc.</b>  RR#, St. Address, Box #: PO Box 668  City, State, ZIP Code: Russell, KS 67665	<b>Global Positioning System</b> (decimal degrees, min. of 4 digits) Latitude: _____ Longitude: _____ Elevation: _____ Datum: _____ Data Collection Method: _____
--	--

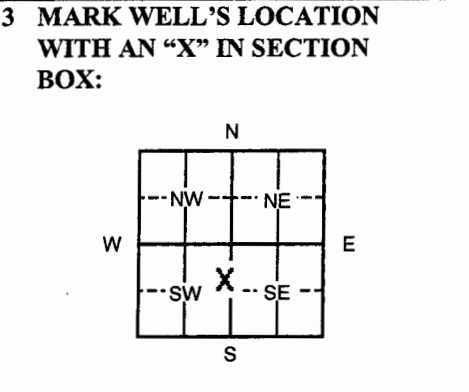

**4 DEPTH OF WELL** 40 ft.

WELL'S STATIC WATER LEVEL 32 ft

WELL WAS USED AS:

1 Domestic	5 Public Water Supply	9 Dewatering
2 Irrigation	6 Oil Field Water Supply	10 Monitoring <input checked="" type="checkbox"/>
3 Feedlot	7 Domestic (Lawn & Garden)	11 Injection Well
4 Industrial	8 Air Conditioning	12 Other _____

Was a chemical/bacteriological sample submitted to Department? Yes \_\_\_ No

**5 TYPE OF BLANK CASING USED:**

1 Steel	3 RMP (SR)	5 Wrought	7 Fiberglass	9 Other (Specify below)
2 PVC X	4 ABS	6 Asbestos-Cement	8 Concrete Tile	_____

Blank casing diameter 2 in. Was casing pulled? Yes  No \_\_\_ If yes, how much 3 feet  
 Casing height above or below land surface \_\_\_\_\_ in.

**6 GROUT PLUG MATERIAL:** 1 Neat cement 2 Cement grout 3 Bentonite  4 Other \_\_\_\_\_

Grout Plug Intervals: From 40 ft. to 3 ft., From \_\_\_\_\_ ft. to \_\_\_\_\_ ft., From \_\_\_\_\_ to \_\_\_\_\_ ft.

What is the nearest source of possible contamination:

1 Septic tank	6 Seepage pit	11 Fuel Storage	16 Other (specify below)
2 Sewer lines	7 Pit privy	12 Fertilizer storage	<u>LUST</u>
3 Watertight sewer lines	8 Sewage lagoon	13 Insecticide storage	
4 Lateral lines	9 Feedyard	14 Abandoned water well	Direction from well?
5 Cess pool	10 Livestock pens	15 Oil well/Gas well	How many feet? <u>0</u>

FROM	TO	PLUGGING MATERIALS	FROM	TO	PLUGGING MATERIALS
40	3	Bentonite Grout			
3	0	Native Soil			
					MLW 3

**7 CONTRACTOR'S OR LANDOWNER'S CERTIFICATION:** This water well was plugged under my jurisdiction and was completed on (mo/day/year) 4/13/2007 and this record is true to the best of my knowledge and belief. Kansas Water Well Contractor's License No. 594. This Water Well Record was completed on (mo/day/year) 5/22/2007 under the business name of Coranco Great Plains, Inc. by (signature)

**INSTRUCTIONS:** Please fill in blanks or circle the correct answers. Send top three copies to Kansas Department of Health and Environment, Bureau of Water, Geology Section, 1000 SW Jackson St., Ste. 420, Topeka, Kansas 66612-1367. Telephone: 785/296-5522. Send one to Water Well Owner and retain one for your records. Visit us at <http://www.kdheks.gov/waterwell>.