# WATER WELL PLUGGING RECORD Form WWC-5P KSA 82a-1212 ID NO. 1008

| 1 LOCATION OF WATER WELL: County: Russell | Fraction ¼ SW ¼ SW ¼ SE ¼ | Section Number 20 | Township Number T 14 S | Range Number 11 ☐ E ☑ W |
|---|---|---|---|---|

Street/Rural Address of Well Location; if unknown, distance & direction from nearest town or intersection: If at owner's address, check here ☐ 2 miles south, 1 1/2 mile east of Dorrance, Ks

**Global Positioning Systems (GPS) information:**
Latitude: _____ (in decimal degrees)
Longitude: _____ (in decimal degrees)
Elevation: _____
Datum: ☐ WGS84, ☐ NAD83, ☐ NAD27
Collection Method:
☐ GPS unit (Make/Model: _____)
☐ Digital Map/Photo, ☐ Topographic Map, ☐ Land Survey
Est. Accuracy: ☐ < 3 m, ☐ 3-5 m, ☐ 5-15 m, ☐ > 15 m

2 **WATER WELL OWNER:** Richard Whitmer
RR#, St. Address, Box #: 20362 Plymouth RD
City, State ZIP Code: Wilson, KS 67490

3 **MARK WELL'S LOCATION WITH AN "X" IN SECTION BOX:**

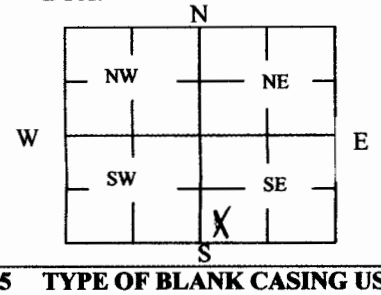


4 **DEPTH OF WELL** 104 ft.
WELL'S STATIC WATER LEVEL _____ ft
WELL WAS USED AS:

| | | | |
|---|---|---|---|
| ☑ Domestic | ☐ Public Water Supply | ☐ Dewatering | |
| ☐ Irrigation | ☐ Oil Field Water Supply | ☐ Monitoring | |
| ☐ Feedlot | ☐ Domestic (Lawn & Garden) | ☐ Injection Well | |
| ☐ Industrial | ☐ Air Conditioning | ☐ Other _____ | |

Was a chemical/bacteriological sample submitted to Department? Yes ☐ No ☑

5 **TYPE OF BLANK CASING USED:**

| | | | | |
|---|---|---|---|---|
| ☐ Steel | ☐ RMP (SR) | ☐ Wrought | ☐ Fiberglass | ☑ Other (Specify below) |
| ☐ PVC | ☐ ABS | ☐ Asbestos-Cement | ☐ Concrete Tile | Tin |

Blank casing diameter 5 in. Was casing pulled? Yes ☐ No ☑ If yes, how much _____
Casing height above or below land surface _____ in.

6 **GROUT PLUG MATERIAL:** ☐ Neat cement ☐ Cement grout ☑ Bentonite ☐ Other _____

Grout Plug Intervals: From 14 ft. to 0 ft., From _____ ft. to _____ ft., From _____ to _____ ft.

What is the nearest source of possible contamination:

| | | | |
|---|---|---|---|
| ☐ Septic tank | ☐ Seepage pit | ☐ Fuel Storage | ☐ Other (specify below) |
| ☐ Sewer lines | ☐ Pit privy | ☐ Fertilizer storage | |
| ☐ Watertight sewer lines | ☐ Sewage lagoon | ☐ Insecticide storage | |
| ☐ Lateral lines | ☐ Feedyard | ☐ Abandoned water well | Direction from well? _____ |
| ☐ Cess pool | ☐ Livestock pens | ☐ Oil well/Gas well | How many feet? _____ |

| FROM | TO | PLUGGING MATERIALS | FROM | TO | PLUGGING MATERIALS |
|---|---|---|---|---|---|
| | | | 14 | 0 | holeplug |
| | | | | | |
| | | | | | |
| | | | | | |
| | | | | | |
| | | | | | |
| | | | | | |

7 **CONTRACTOR'S OR LANDOWNER'S CERTIFICATION:** This water well was plugged under my jurisdiction and was completed on (mo/day/year) 3/15/10 and this record is true to the best of my knowledge and belief. Kansas Water Well Contractor's License No. 0199. This Water Well Record was completed on (mo/day/year) 4/7/10 under the business name of Karst Water Well Drilling & Service, Inc by (signature) _____

**INSTRUCTIONS:** Use typewriter or ballpoint pen. Please press firmly and print clearly. Please fill in blanks, underline or circle the correct answers. Send top three copies to Kansas Department of Health and Environment, Bureau of Water, Geology Section, 1000 SW Jackson St., Ste. 420, Topeka, Kansas 66612-1367. Telephone: 785/296-5524. Send one to Water Well Owner and retain one for your records. Visit us at http://www.kdheks.gov/waterwell/index.html.

Check one: ☑ White Copy ☐ Blue Copy ☐ Pink Copy