


1 LOCATION OF WATER WELL: County: Russell Fraction: SW 1/4 S2 1/4 SW 1/4 Section Number: 7 Township Number: T 14 S Range Number: R 11 E
 Distance and direction from nearest town or city street address of well if located within city? In the town of Dorrance

2 WATER WELL OWNER: JACKIE BREWER
 RR#, St. Address, Box #: Box 52 Board of Agriculture, Division of Water Resources
 City, State, ZIP Code: DORRANCE, KS Application Number: _____

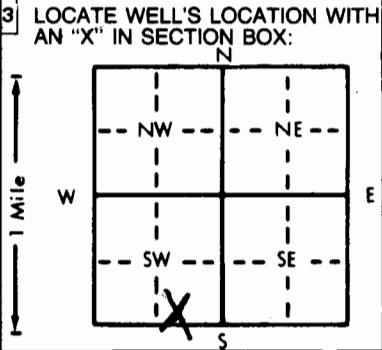

4 DEPTH OF COMPLETED WELL: 7-10-88 feet
 Depth(s) Groundwater Encountered: 1.32 ft. 2. _____ ft. 3. _____ ft.
 WELL'S STATIC WATER LEVEL: 3.4 ft. below land surface measured on mo/day/yr 4-13-88
 Pump test data: Well water was _____ ft. after _____ hours pumping _____ gpm
 Est. Yield: 5 gpm; Well water was _____ ft. after _____ hours pumping _____ gpm
 Bore Hole Diameter: 9 in. to _____ ft., and _____ in. to _____ ft.
 WELL WATER TO BE USED AS:
 1 Domestic 3 Feedlot 6 Oil field water supply 9 Dewatering 12 Other (Specify below)
 2 Irrigation 4 Industrial 7 Lawn and garden only 10 Observation well
 Was a chemical/bacteriological sample submitted to Department? Yes _____ No (No) If yes, mo/day/yr sample was submitted _____
 Water Well Disinfected? Yes (No) No _____

5 TYPE OF BLANK CASING USED:
 1 Steel 3 RMP (SR) 5 Wrought iron 8 Concrete tile CASING JOINTS: (Glued) _____ Clamped _____
 2 PVC 4 ABS 6 Asbestos-Cement 9 Other (specify below) _____ Welded _____
 7 Fiberglass _____ Threaded _____
 Blank casing diameter: 5 in. to 5.2 ft., Dia _____ in. to _____ ft., Dia _____ in. to _____ ft.
 Casing height above land surface: _____ in., weight _____ lbs./ft. Wall thickness or gauge No. 54 R26
 TYPE OF SCREEN OR PERFORATION MATERIAL:
 1 Steel 3 Stainless steel 5 Fiberglass 8 RMP (SR) 10 Asbestos-cement
 2 Brass 4 Galvanized steel 6 Concrete tile 9 ABS 11 Other (specify) _____
 12 None used (open hole)
 SCREEN OR PERFORATION OPENINGS ARE:
 1 Continuous slot 3 Mill slot 5 Gauzed wrapped 8 Saw cut 11 None (open hole)
 2 Louvered shutter 4 Key punched 6 Wire wrapped 9 Drilled holes
 7 Torch cut 10 Other (specify) _____
 SCREEN-PERFORATED INTERVALS: From 52 ft. to 62 ft., From _____ ft. to _____ ft.
 From _____ ft. to _____ ft., From _____ ft. to _____ ft.
 GRAVEL PACK INTERVALS: From 50 ft. to 62 ft., From _____ ft. to _____ ft.
 From _____ ft. to _____ ft., From _____ ft. to _____ ft.

6 GROUT MATERIAL: (Neat cement) 2 Cement grout 3 Bentonite 4 Other Clay Backfill
 Grout Intervals: From 0 ft. to 20 ft., From _____ ft. to _____ ft., From 50 ft. to 20 ft.
 What is the nearest source of possible contamination:
 1 Septic tank 4 Lateral lines 7 Pit privy 10 Livestock pens 14 Abandoned water well
 2 Sewer lines 5 Cess pool 8 Sewage lagoon 11 Fuel storage 15 Oil well/Gas well
 3 Watertight sewer lines 6 Seepage pit 9 Feedyard 12 Fertilizer storage 16 Other (specify below)
 13 Insecticide storage _____

Direction from well? _____ How many feet? _____

FROM	TO	LITHOLOGIC LOG	FROM	TO	LITHOLOGIC LOG
0	3	Top soil			
3	38	Brown clay			
38	39	SAND FINE			
39	49	SAND CLAY			
49	58	Light Brown			
58	62	SAND Rock			

7 CONTRACTOR'S OR LANDOWNER'S CERTIFICATION: This water well was (1) constructed (2) reconstructed, or (3) plugged under my jurisdiction and was completed on (mo/day/year) 4-15-88 and this record is true to the best of my knowledge and belief, Kansas Water Well Contractor's License No. 485A. This Water Well Record was completed on (mo/day/yr) 4-15-88 under the business name of Bushnell Waterwell Drilling (signature) Lois Bushnell