


1 LOCATION OF WATER WELL: Fraction NE 1/4 NW 1/4 NW 1/4 Section Number 9 Township Number T 14 S Range Number R 11 E/W
 County: Russell

Distance and direction from nearest town or city street address of well if located within city?

1/2 East of Dorrance

2 WATER WELL OWNER: P. S. Reilly 67634
 RR#, St. Address, Box #: 20120 Grant Lane Dorrance, KS
 City, State, ZIP Code: Dorrance, KS Board of Agriculture, Division of Water Resources Application Number:

3 LOCATE WELL'S LOCATION WITH AN "X" IN SECTION BOX: 4 DEPTH OF COMPLETED WELL: 35 ft. ELEVATION: 31 ft.

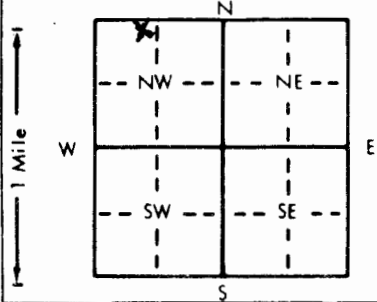

Depth(s) Groundwater Encountered 1. 31 ft. 2. _____ ft. 3. _____ ft.
 WELL'S STATIC WATER LEVEL 18 ft. below land surface measured on mo/day/yr 9-12-94
 Pump test data: Well water was _____ ft. after 1 hours pumping 5 gpm
 Est. Yield 5 gpm; Well water was _____ ft. after _____ hours pumping _____ gpm
 Bore Hole Diameter: 8 1/2 in. to 35 ft., and _____ in. to _____ ft.
 WELL WATER TO BE USED AS: 5 Public water supply 8 Air conditioning 11 Injection well
 1 Domestic 3 Feedlot 6 Oil field water supply 9 Dewatering 12 Other (Specify below)
 2 Irrigation 4 Industrial 7 Lawn and garden only 10 Monitoring well
 Was a chemical/bacteriological sample submitted to Department? Yes No; If yes, mo/day/yr sample was submitted _____
 Water Well Disinfected? Yes No

5 TYPE OF BLANK CASING USED: 5 Wrought iron 8 Concrete tile CASING JOINTS: Glued Clamped _____
 1 Steel 3 RMP (SR) 6 Asbestos-Cement 9 Other (specify below) Welded _____
2 PVC 4 ABS 7 Fiberglass Threaded _____
 Blank casing diameter 4 in. to 25 ft. Dia _____ in. to _____ ft. Dia _____ in. to _____ ft.
 Casing height above land surface 12 in., weight _____ lbs./ft. Wall thickness or gauge No. SDR 26

TYPE OF SCREEN OR PERFORATION MATERIAL: 7 PVC 10 Asbestos-cement
 1 Steel 3 Stainless steel 5 Fiberglass 8 RMP (SR) 11 Other (specify) _____
 2 Brass 4 Galvanized steel 6 Concrete tile 9 ABS 12 None used (open hole)

SCREEN OR PERFORATION OPENINGS ARE: 5 Gauzed wrapped 8 Saw cut 11 None (open hole)
 1 Continuous slot 3 Mill slot 6 Wire wrapped 9 Drilled holes
 2 Louvered shutter 4 Key punched 7 Torch cut 10 Other (specify) _____

SCREEN-PERFORATED INTERVALS: From 25 ft. to 35 ft. From _____ ft. to _____ ft.
 From _____ ft. to _____ ft. From _____ ft. to _____ ft.
 GRAVEL PACK INTERVALS: From 27 ft. to 35 ft. From _____ ft. to _____ ft.
 From _____ ft. to _____ ft. From _____ ft. to _____ ft.

6 GROUT MATERIAL: 1 Neat cement 2 Cement grout 3 Bentonite 4 Other _____
 Grout Intervals: From 0 ft. to 20 ft. From _____ ft. to _____ ft. From _____ ft. to _____ ft.
 What is the nearest source of possible contamination: 10 Livestock pens 14 Abandoned water well
 1 Septic tank 4 Lateral lines 7 Pit privy 11 Fuel storage 15 Oil well/Gas well
 2 Sewer lines 5 Cess pool 8 Sewage lagoon 12 Fertilizer storage 16 Other (specify below)
 3 Watertight sewer lines 6 Seepage pit 9 Feedyard 13 Insecticide storage

Direction from well? East How many feet? 100

FROM	TO	LITHOLOGIC LOG	FROM	TO	PLUGGING INTERVALS
0	3	Top soil			
3	26	Dark clay			
26	29	Light white clay			
29	33	yellow fine clay fine sand			
33	35	light clay			

7 CONTRACTOR'S OR LANDOWNER'S CERTIFICATION: This water well was 1 constructed, (2) reconstructed, or (3) plugged under my jurisdiction and was completed on (mo/day/year) 9-12-94 and this record is true to the best of my knowledge and belief. Kansas Water Well Contractor's License No. 485 This Water Well Record was completed on (mo/day/yr) 10-7-94 under the business name of Bushell water well Drilling Ser. by (signature) Louis Bushell