


1 LOCATION OF WATER WELL: County: Russell Fraction NW 1/4 NE 1/4 NE 1/4 Section Number 25 Township Number T 14 S Range Number R 12

Distance and direction from nearest town or city street address of well if located within city? 2 South of Dorrance

2 WATER WELL OWNER: Jake Herbel RR#, St. Address, Box #: Dorrance, Kansas 67634 Board of Agriculture, Division of Water Resources Application Number:

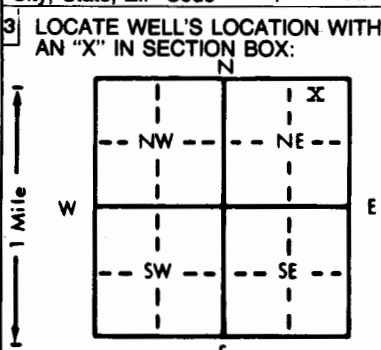

3 LOCATE WELL'S LOCATION WITH AN "X" IN SECTION BOX: 4 DEPTH OF COMPLETED WELL: 95 ft. ELEVATION: Upland Depth(s) Groundwater Encountered 1. 37 ft. 2. ft. 3. ft. WELL'S STATIC WATER LEVEL: 25 ft. below land surface measured on mo/day/yr October 29, 1986. Pump test data: Well water was 35 ft. after 1 hours pumping 15 gpm. Est. Yield 15 gpm: Well water was ft. after hours pumping gpm. Bore Hole Diameter 10 in. to 95 ft., and in. to ft. WELL WATER TO BE USED AS: 1 Domestic 3 Feedlot 6 Oil field water supply 9 Dewatering 12 Other (Specify below) 2 Irrigation 4 Industrial 7 Lawn and garden only 10 Observation well Was a chemical/bacteriological sample submitted to Department? Yes No X; If yes, mo/day/yr sample was submitted Water Well Disinfected? Yes X No

5 TYPE OF BLANK CASING USED: 2 5 Wrought iron 8 Concrete tile CASING JOINTS: Glued X Clamped 1 Steel 3 RMP (SR) 6 Asbestos-Cement 9 Other (specify below) Welded 2 PVC 4 ABS 7 Fiberglass Threaded Blank casing diameter 5 in. to 75 ft., Dia. in. to ft., Dia. in. to ft. Casing height above land surface 24 in., weight 200 lbs./ft. Wall thickness or gauge No. .21 TYPE OF SCREEN OR PERFORATION MATERIAL: 7 7 PVC 10 Asbestos-cement 1 Steel 3 Stainless steel 5 Fiberglass 8 RMP (SR) 11 Other (specify) 2 Brass 4 Galvanized steel 6 Concrete tile 9 ABS 12 None used (open hole) SCREEN OR PERFORATION OPENINGS ARE: 8 5 Gauzed wrapped 8 Saw cut 11 None (open hole) 1 Continuous slot 3 Mill slot 6 Wire wrapped 9 Drilled holes 2 Louvered shutter 4 Key punched 7 Torch cut 10 Other (specify) SCREEN-PERFORATED INTERVALS: From 75 ft. to 95 ft., From ft. to ft. GRAVEL PACK INTERVALS: From 35 ft. to 95 ft., From ft. to ft.

6 GROUT MATERIAL: 1 1 Neat cement 2 Cement grout 3 Bentonite 4 Other Grout Intervals: From 4 ft. to 14 ft., From ft. to ft., From ft. to ft. What is the nearest source of possible contamination: None 10 Livestock pens 14 Abandoned water well 1 Septic tank 4 Lateral lines 7 Pit privy 11 Fuel storage 15 Oil well/Gas well 2 Sewer lines 5 Cess pool 8 Sewage lagoon 12 Fertilizer storage 16 Other (specify below) 3 Watertight sewer lines 6 Seepage pit 9 Feedyard 13 Insecticide storage Direction from well? How many feet?

Table with columns FROM, TO, LITHOLOGIC LOG. Data rows: 0-7 Topsoil, 7-18 Brown clay, 18-35 White rock and clay, 35-51 Gray clay and rock and sand, 51-63 Bray clay, 63-95 Red clay.

7 CONTRACTOR'S OR LANDOWNER'S CERTIFICATION: This water well was (1) constructed, (2) reconstructed, or (3) plugged under my jurisdiction and was completed on (mo/day/year) October 29, 1986 and this record is true to the best of my knowledge and belief. Kansas Water Well Contractor's License No. 199 This Water Well Record was completed on (mo/day/yr) January 30, 1987 under the business name of Karst Water Well Drilling & Service, Inc by (signature)

INSTRUCTIONS: Use typewriter or ball point pen. PLEASE PRESS FIRMLY and PRINT clearly. Please fill in blanks, underline or circle the correct answers. Send top three copies to Kansas Department of Health and Environment, Office of Oil Field and Environmental Geology, Regulation and Permitting Section, Topeka, Kansas 66620-7500, Telephone: 913-862-9360. Send one to WATER WELL OWNER and retain one for your records.